


Section 16 Township 14 Range 15-W

Well No. #1 Rouback

Company ~~Harry Gore~~ Nate Appleman

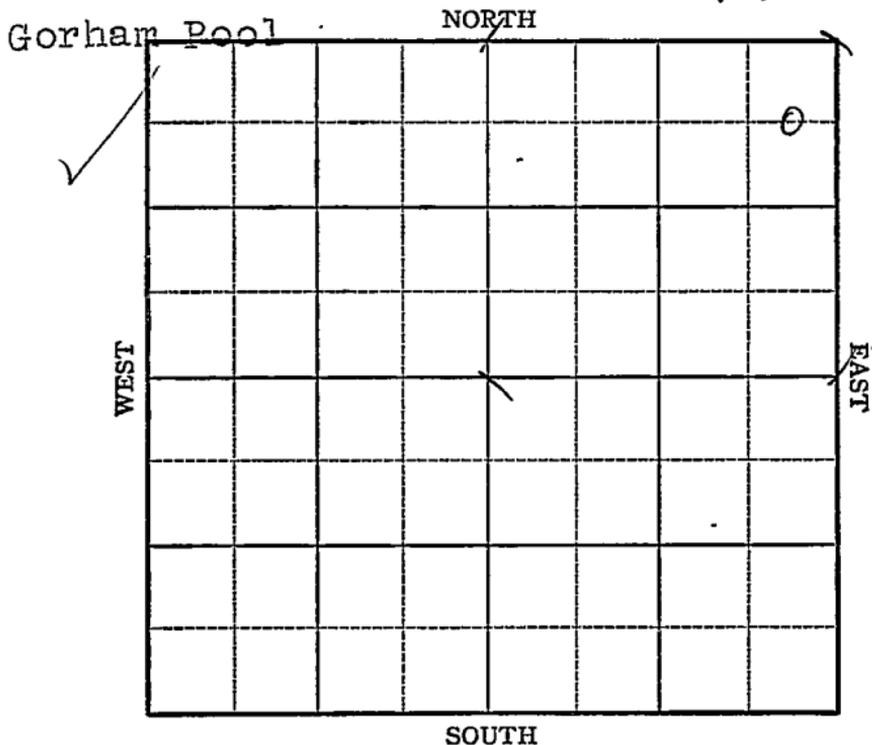

Sec. 16 Twp. 14 R. 15-W

Well No. #1 Rouback C Farm

~~Harry Gore~~ Nate Appleman Company  
(Gorham Pool)


660 Ft. from N. Line

\_\_\_\_\_ Ft. from S. Line

330 Ft. from E. Line

\_\_\_\_\_ Ft. from W. Line

Elev. 1856

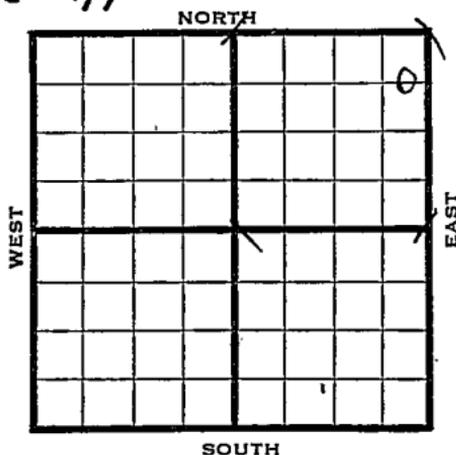

1942

REPORT

8/12 Cable.

8/19 Spud

8/27 15" @ 400', 12" @ 635  
Anhy 900, 10" @ 925 Drlg 940

9/2 Drlg. 2100'

9/9 Drlg 2697' 8" @ 2497

9/16 8" @ 2730 Lans 3007  
pay 3030-38 TD 700' oil Run 6"/

9/23 6" 3027' 500 Acid  
swab 5 Oil per hour

9/30 " " "

10/7 Lans. 3007  
6" - 3027  
500 acid  
T.D. 3044  
Pump 545 Pot.  
Gravity 36.5

**COMPLETED**

Map No. 72 Sec. 16 Twp. 14 R. 15W

Well No. 1 Rouback

Harry Gore Company

**FIRST REPORT** Contractor

**C E L N E N E**  
660 Ft. from N. Line


\_\_\_\_\_ Ft. from S. Line

330 Ft. from E. Line

\_\_\_\_\_ Ft. from W. Line

**GORHAM POOL**

**SECTION PLAT**

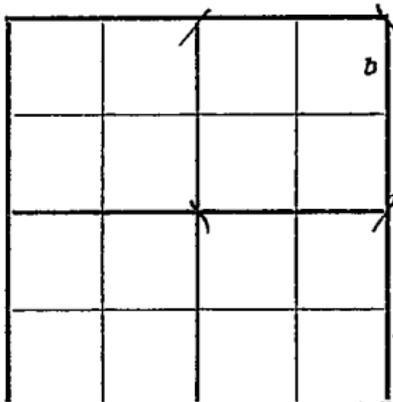

Location \_\_\_\_\_

Rig up \_\_\_\_\_

Drilling and Remarks:  
Cable

**RECORD**

Cased \_\_\_\_\_ in., \_\_\_\_\_ ft.

Sand \_\_\_\_\_

Gas \_\_\_\_\_

Oil \_\_\_\_\_

Total Depth \_\_\_\_\_

**PRODUCTION**

1st 24 hrs. Nat. \_\_\_\_\_

1st 24 hrs. after shot \_\_\_\_\_

Gas \_\_\_\_\_ Cu. Ft.

Dry Hole \_\_\_\_\_

Abandoned \_\_\_\_\_

Date

AUG 12 1942 19

S. J. LEWIS Scout

Rus sell

Map No. 72 Sec. 16 Twp. 14 R. 15WWell No. 1 Rouback "C"

Nate Appleman

Company

CORRECTION

Contractor

C E L N E N E

## SECTION PLAT

			o

660 Ft. from N. Line

\_\_\_\_\_ Ft. from S. Line

330 Ft. from E. Line

\_\_\_\_\_ Ft. from W. Line

GORHAM POOL

Location \_\_\_\_\_

Rig up \_\_\_\_\_

Drilling and Remarks:

Reported as  
Harry Gore  
#1 Rouback

## RECORD

Cased \_\_\_\_\_ in., \_\_\_\_\_ ft.

Sand \_\_\_\_\_

Gas \_\_\_\_\_

Oil \_\_\_\_\_

Total Depth \_\_\_\_\_

## PRODUCTION

1st 24 hrs. Nat. \_\_\_\_\_

1st 24 hrs. after shot \_\_\_\_\_

Gas \_\_\_\_\_ Cu. Ft.

Dry Hole \_\_\_\_\_

Abandoned \_\_\_\_\_

Date

SEP 23 1942

19

S. J. LEWIS Scout

Map No. 72 Sec. 16 Twp. 14 R. 15WWell No. 1 Roubach "C"

Nate Appleman

Company

**COMPLETED**

Contractor

C E L N E N E

SECTION PLAT

660 Ft. from N. Line

Ft. from S. Line

330 Ft. from E. Line

Ft. from W. Line

			0

GORHAM POOL

Location

Rig up

Drilling and Remarks:

*Leas 3007**6" 08027**500 acid**Pump 545 Pst**365 Gr*

RECORD

Cased \_\_\_\_\_ in., \_\_\_\_\_ ft.

Sand \_\_\_\_\_

Gas \_\_\_\_\_

Oil \_\_\_\_\_

Total Depth 3047

PRODUCTION

1st 24 hrs. Nat. \_\_\_\_\_

1st 24 hrs. after shot \_\_\_\_\_

Gas \_\_\_\_\_ Cu. Ft.

Dry Hole \_\_\_\_\_

Abandoned \_\_\_\_\_

Date

OCT 7 1942

19

S. J. LEWIS Scout