


DX 78-1

Section 17 Township 14 Range 16 W

Well No. #1 Kuhn

Company Jones, Shelburne & Farmer

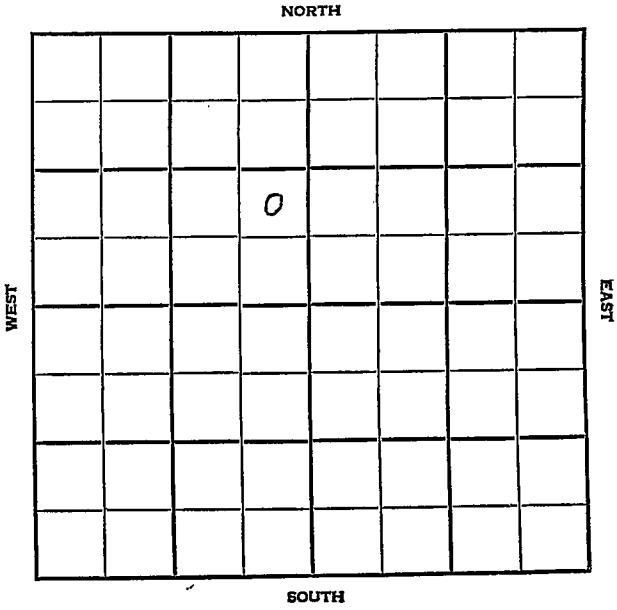

SEC. 17	TWP. 14	R. 16W
------------	------------	-----------

WELL NO.

#1 Kuhn

FARM

COMPANY

Jones, Shelburne, & Farmer

CONTRACTOR

Co. Tools


_____ Ft. from N. Line

_____ Ft. from S. Line

_____ Ft. from E. Line

_____ Ft. from W. Line

NE SE NW

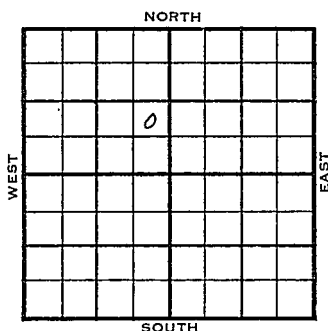

1956	ELEVATION 1914	REPORT
2-15		Comm. 2-10-56 8" @ 179/125 Drlg. 1675' Anh. 1040
4-4		DST 3185-3202 op 1 hr. rec. 50' wm, 660/20" DST 3238-70 op 1 hr. rec. 165' msw, 815/20" DST 3348-76 op 1 hr. rec. 540' GIP, 60' hocm, 1120/20" 5½" @ 3475/150 CO 20/ 3349-54, 500 A S/ 3.68 boph, 1500 A S/ 3½ boph, Comp. 15 bopd Anh. 1040 H. 3124 Tr. 3143 L. 3173 BKC 3408 C. 3419 A. 3467 TD 3475

COMPLETED

County Elvis Elev. _____
 Sec. 17 Twp. 14 Rge. 16W
 Company Jones, Shelburne & Farmer
 FarmName Kuhn No. 1

TOPS	DEPTH	LOG	DATUM
Anh.	<u>1040</u>		
Tr.			
H.			
Tr.			
Dg.			
Bl.			
L.			
K.C.			
B.K.C.			
Ce.			
C.			
M.			
M.			
K.			
Mz.			
Mo.			
V.			
S.			
S.			
A.			
R.			
Pe.			
G.			
T.D.			

Loc. in Sec. NE SE NW
 Geol. _____
 Contr. _____
 Co. tools _____
 Pool _____

	○	
	FEB 15 '56	
FIRST REPORT		

Date Comm. 2-10-56
8" @ 179/125 drlg. 1675

~~Handwritten signature/initials~~

Co.
Lse.
No.
Sec.
T.
R.

County Elis Elev. 1914
 Sec. 17 Twp. 14 Rge. 16W
 Company Jones, Shelburne & Farmer
 FarmName Kuhn No. 1

TOPS	DEPTH	LOG	DATUM	Loc. in Sec.
Anh.	<u>1040</u>			NE SE NW
Tp.				
H.	<u>3124</u>			
Tr.	<u>3143</u>			
Dg.				
Bl.				
L.	<u>3173</u>		<u>1259</u>	Geol.
K.C.				Contr.
B.K.C.	<u>3403</u>		<u>1489</u>	Co. tools
Ce.				Pool
C.	<u>3419</u>		<u>1505</u>	
M.				
M.				
K.				
Mz.				
Me.				
V.				
S.				
S.				
A.	<u>3467</u>		<u>1653</u>	<div style="border: 1px dashed black; padding: 5px; text-align: center;"> COMPLETE APR 4 '56 </div>
R.				
PE.				
G.				
T.D.	<u>3475</u>			

Date Comm. 2-10-56

8" @ 179/125 DST 3185-3202 open 1 hr.

rec. 50' wm 660/20" DST 3238-70

open 1 hr. rec. 165' msw 815/20"

DST 3348-76 open 1 hr. rec. 540' GIP

60' hocm 1120/20" 5½" @ 3475/150

CO 20/ 3349-54 500 A S/ 3.68 boph

1500 A S/ 3½ boph Comp. 15 bopd