

KANSAS Russell

FORM 51 25M 3-49 PETROL

Section 17 Township 14 Range 15-W

Well No. #1 Smith

Company M B Armer
Wildcat

NORTH

									o

SOUTH

Sec. 17 Twp. 14 R. 15W

Well No. #1 Smith Farm

M. B. Armer Company

Armer Contractor

Wildcat


_____ Ft. from N. Line

330' Ft. from S. Line

330' Ft. from E. Line

_____ Ft. from W. Line

SE/C

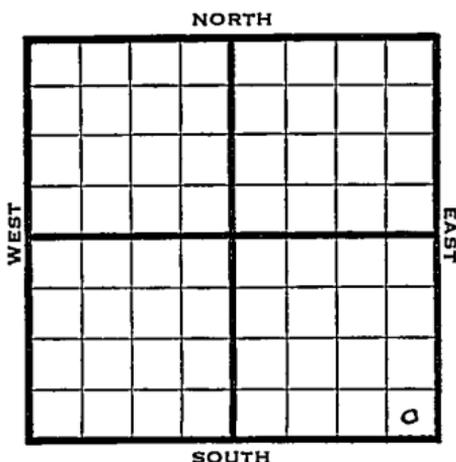

1949 Elev 1830' REPORT

10/26
11/1
11/9

8" @ 159'
Drlg. 2900'
TD 3347'
Lansing 3057'
Arb. 3329'
Aband.

ABANDONED

Map No. _____ Sec. 17 Twp. 14 R. 15W

Well No. 1 Smith

M. B. Armer Company

Armer Contractor

SE/C

**FIRST REPORT
 SECTION PLAT**

_____ Ft. from N. Line

330 Ft. from S. Line

330 Ft. from E. Line

_____ Ft. from W. Line

Russell County

Location _____

Rig up _____

Drilling and Remarks:

8" @ 159

RECORD

Cased _____ in., _____ ft.

Sand _____

Gas _____

Oil _____

Total Depth _____

PRODUCTION

1st 24 hrs. Nat. _____

1st 24 hrs. after shot _____

Gas _____ Cu. Ft.

Dry Hole _____

Abandoned _____

Date

OCT 26 1949 19

S. J. LEWIS Scout

Kansas

Map No. _____ Sec. 17 Twp. 14 R. 15W

Well No. 1 Smith

M. B. Armer Company

ABANDONED Contractor

SE/C

E. 1/830
SECTION PLAT

_____ Ft. from N. Line

330 Ft. from S. Line

330 Ft. from E. Line

_____ Ft. from W. Line

			0

Russell County

Location _____

Rig up _____

Drilling and Remarks:

Ham 3057

Car 2329

RECORD

Cased _____ in., _____ ft.

Sand _____

Gas _____

Oil _____

Total Depth 2247

PRODUCTION

1st 24 hrs. Nat. _____

1st 24 hrs. after shot _____

Gas _____ Cu. Ft.

Dry Hole _____

Abandoned _____

Date

NOV 9 1949 19

S. J. LEWIS Scout