


Section 17 Township 14- Range 14W

Well Number 2 Vaughn

Company Empire

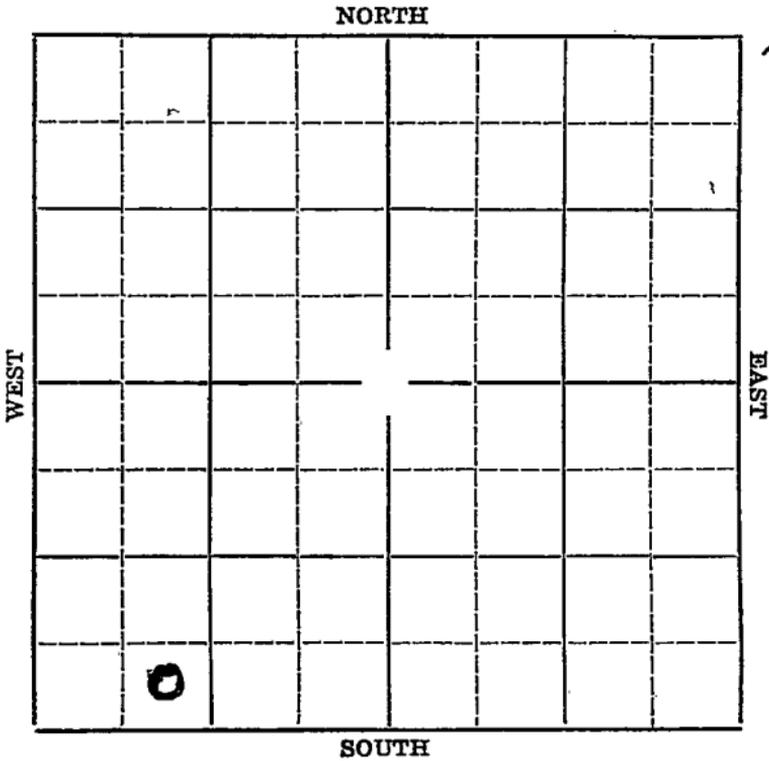

Sec. 17 Twp. 14 R. 14-W

Well No. #2 Vaughn Farm

Empire Company


 Ft. from N. Line

330 Ft. from S. Line

 Ft. from E. Line

990 Ft. from W. Line

Elev. 1861

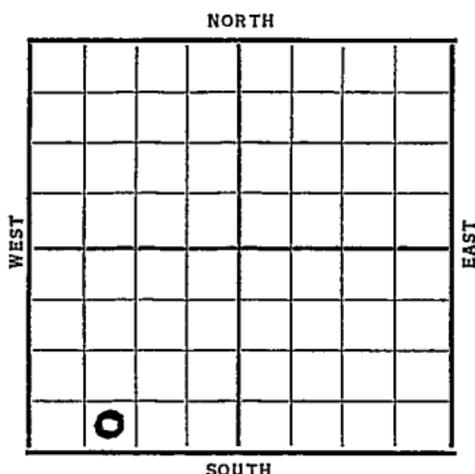

Date	REPORT
1937	
4/21	Rig
4/30	Surface hole.
5/7	15" @ 333'. Drlg. 1579'.
5/14	Anhy 838'. Drlg. 2365'.
5/21	Osw. 3010'. 8" @ 3016' T.D.
5/28	Bailing.
6/2	8" @ 3016'.
	Oswald 3010'.
	T.D. 3060'.
	2000 acid.
	Potential 679 bbls. 24 hrs.
	COMPLETED

KANSAS

Russell

Map No. _____ Sec. 17 Twp. 14 R. 14WWell No. 2. VaughanEmpire Company

Contractor _____

SECTION PLAT

_____ Ft. from N. Line

330 Ft. from S. Line

_____ Ft. from E. Line

990 Ft. from W. Line

FIRST REPORT

Location _____

Rig up _____

Drilling and Remarks:

Rig

RECORD

Cased _____ in., _____ ft.

Sand _____

Gas _____

Oil _____

Total Depth _____

PRODUCTION

1st 24 hrs. Nat. _____

1st 24 hrs. after shot _____

Gas _____ Cu. Ft.

Dry Hole _____

Abandoned _____

Date

APR 21 1937 19

S. J. LEWIS Scout

Russell

KANSAS

Map No. 72 Sec. 17 Twp. 14 R. 14W

Well No. 2 - Vaughn

Empire Company

Contractor

COMPLETED

SECTION PLAT

_____ Ft. from N. Line

330 Ft. from S. Line

_____ Ft. from E. Line

990 Ft. from W. Line

0			

Location _____

RECORD

Rig up _____

Cased 8 in., 3016 ft.

Drilling and Remarks:

Sand Oswald 3010

2000 Acid

Gas _____

Oil _____

Total Depth 3060

PRODUCTION

1st 24 hrs. Nat. _____

1st 24 hrs. after shot _____

Gas _____ Cu. Ft.

Dry Hole: _____

Abandoned _____

Pat 679 / 24 hrs

Date

JUN 2 1937 19 H. D. Hatfield Scout