


Section 17 Township 14 Range 14TH

Well No. #4 Vaughn

Company Cities Ser. Oil

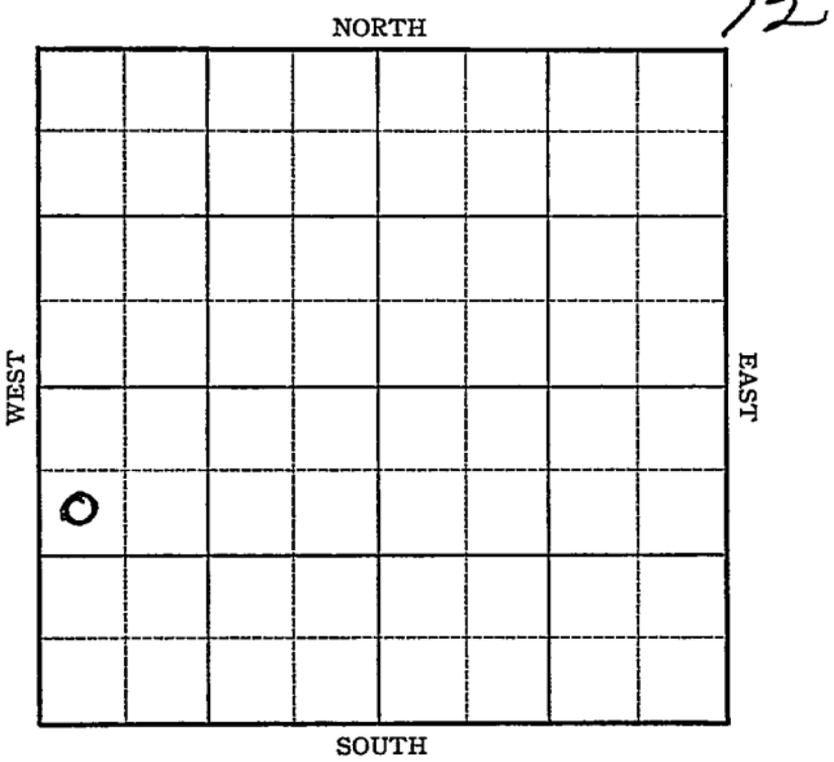

Sec. 17 Twp. 14 R. 14W

Well No. 4-Vaughn Farm

Cities Ser Oil Company


990 Ft. from N. Line

_____ Ft. from S. Line

_____ Ft. from E. Line

330 Ft. from W. Line

Elev. 1879

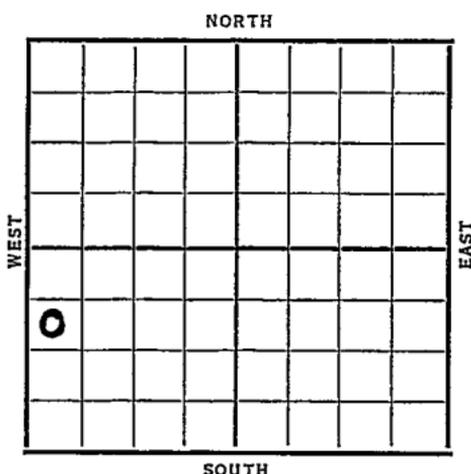

Date	REPORT
1937 8/11	Spud
8/20	12" @ 330'. Anhy 880'. Drl g. 1750'.
8/28	T.D. 3020' coring.
9/3	K.C. 3026'. 8" @ 3030'. WOC. No shows.
9/10	" " "
9/15	8" @ 3030'
	KC 3026'
	TD 3065'
	2000 acid
	Pot 1562'
	COMPLETED

Russell **KANSAS**Map No. _____ Sec. 17 Twp. 14 R. 14 WWell No. 4 - VaughnCities Ser Oil Company

Contractor

FIRST REPORT

990 Ft. from N. Line

_____ Ft. from S. Line

_____ Ft. from E. Line

330 Ft. from W. Line

SECTION PLAT

0			

Location _____

Rig up _____

Drilling and Remarks:

Spud

RECORD

Cased _____ in., _____ ft.

Sand _____

Gas _____

Oil _____

Total Depth _____

PRODUCTION

1st 24 hrs. Nat. _____

1st 24 hrs. after shot _____

Gas _____ Cu. Ft.

Dry Hole _____

Abandoned _____

Date

AUG 11 1937 19

H. D. Hatfield Scout

Russell KANSAS

Map No. _____ Sec. 17 Twp. 14 R. 14^W

Well No. 4-Vaughan

Cities Service Company

Contractor _____

SECTION PLAT

COMPLETE

990 Ft. from N. Line
 _____ Ft. from S. Line
 _____ Ft. from E. Line
330 Ft. from W. Line

0			

Location _____

Rig up _____

Drilling and Remarks:

2000 acid
pot-1562

RECORD

Cased 8 in., 3030 ft.

Sand KC 3026

Gas _____

Oil _____

Total Depth 3065

PRODUCTION

1st 24 hrs. Nat. _____

1st 24 hrs. after shot _____

Gas _____ Cu. Ft.

Dry Hole _____

Abandoned _____

Date

~~SEP~~ 15 1937 19

H. D. Hatfield Scout