


Section 18 Township 14 Range 16W

Well No. 1 Brungardt

Company Raymond Gear

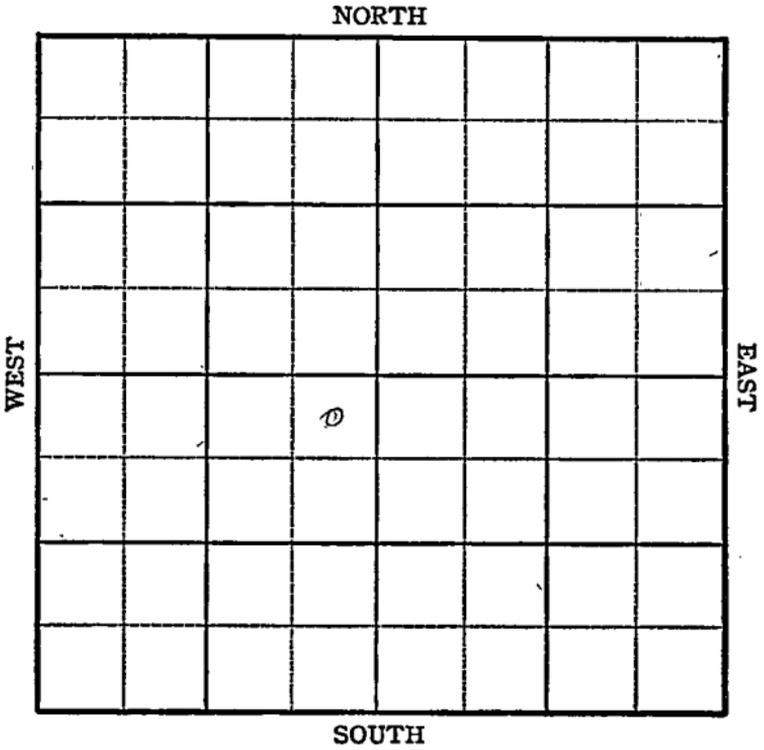

Sec. 18 Twp. 14 R. 16-W


Well No. #1 Brumgardt Farm
Raymond Gear Company

330 Ft. from N. Line

_____ Ft. from S. Line

330 Ft. from E. Line

_____ Ft. from W. Line

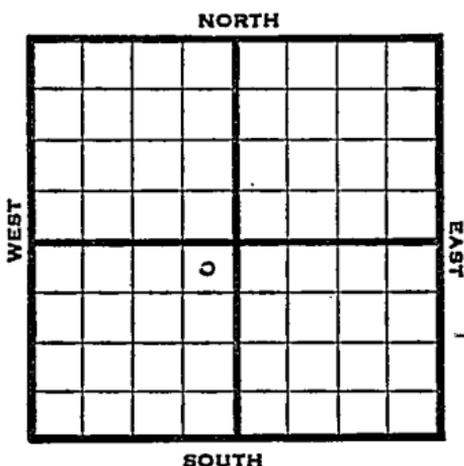

NE SW -

1945 ELEV. 1906 REPORT

- 11/14 Location.
- 11/21 Anhy. 1035
10" @ 1040' : WOC
- 11/28 Drlg. 2970'
- 12/5 Lans 3175
Arb. 3421
TD 3451'

ABANDONED

Kansas Pool Name WildcatMap No. 71 ~~KANSAS~~ Sec. 18 Twp. 14 R. 16WWell No. 1 BrumgardtRaymond Gear CompanyFIRST REPORT Contractor

NE SW

SECTION PLAT

330 Ft. from N. Line

_____ Ft. from S. Line

330 Ft. from E. Line

_____ Ft. from W. Line

	o		

Ellis County

Location X

Rig up _____

Drilling and Remarks:

RECORD

Cased _____ in., _____ ft.

Sand _____

Gas _____

Oil _____

Total Depth _____

PRODUCTION

1st 24 hrs. Nat. _____

1st 24 hrs. after shot _____

Gas _____ Cu. Ft.

Dry Hole _____

Abandoned _____

Date

NOV 14 1945

19

S. J. LEWIS

Scout

KANSAS

Kansas Pool Name Wildcat

Map No K-71 Sec. 18 Twp. 14 R. 16W

Well No. 1 Brumgardt

Raymond Gear Company

ABANDONED

Contractor

NE SW

E11906
SECTION PLAT

330 Ft. from N. Line

 Ft. from S. Line

330 Ft. from E. Line

 Ft. from W. Line

	6		

Ellis County

Location _____

Rig up _____

Drilling and Remarks:

Law 3175
Or 3421

RECORD

Cased _____ in., _____ ft.

Sand _____

Gas _____

Oil _____

Total Depth 3457

PRODUCTION

1st 24 hrs. Nat. _____

1st 24 hrs. after shot _____

Gas _____ Cu. Ft.

Dry Hole _____

Abandoned _____

Date

12

DEC 5 1945 19

S. J. LEWIS Scout