


Section 18 Township 14 Range 16-W

Well No. 1 - Phillips

Company Buffalo Oil

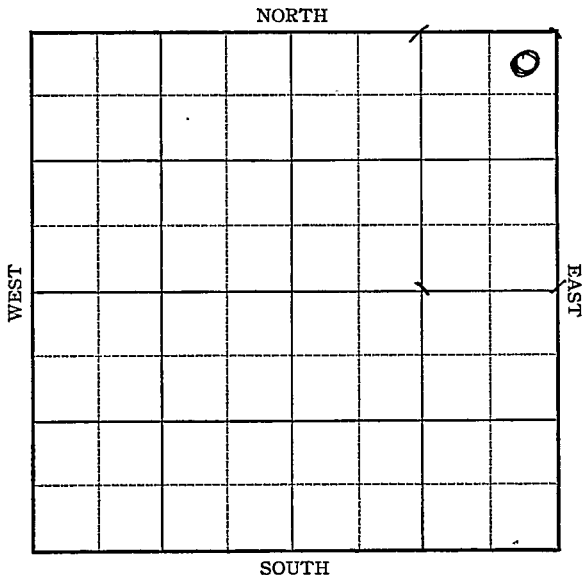

KANSAS

ELLIS

Sec. 18 Twp. 14 R. 16^W

Well No. #1 Phillip Farm

Buffalo Oil Company


NE/c

330 Ft. from N. Line

_____ Ft. from S. Line

330 Ft. from E. Line

Ft. from W. Line

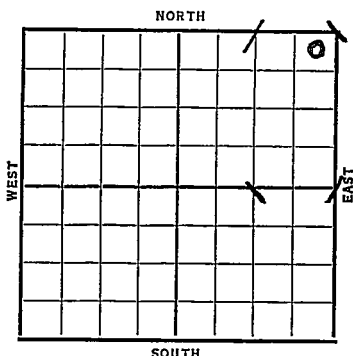

Special

Date	REPORT
1937	
8/25	R.R.
9/3	10" @ 75'. Anhy 1050'.
	Drlg. 2230'.
9/9	Top Conglomerate 3422 No show oil or gas Top Siliceous 3433 Small show oil to 3435 Cored 3435-3446--recovered $8\frac{1}{2}$ feet saturated Siliceous lime (Tel)
9/10	Topeka 2915'. K.C. 3174' S.S.O. 3209-19 $\frac{1}{2}$. Cored 3219 $\frac{1}{2}$ -33'. Rec 11'. S.S.O. in bottom. show dead oil 3222-29'. Inc. in oil show 3229-31'. Gas 3422 . Sil. 3433'. 3422' T.D. 3435'. S.S.O.
9/17	Sil. 3422(Corrected) 6" @ 3429'. T.D. 3435'. 500 acid-wouldn't take.
	OVER

1937

9/24 46 shots with lane gun.
8 in csg. and 38 in Sil. lime.
1000 acid. 136 bbl. load.
Swabbing. Shot 20 qts. no
Inc. Core 3446-60' T.D.
H.F.W. 3456-60'. P.B. to K.C.

10/2 P.B. 3364' perforated pipe
3260-68 & 3225-28'.
Swb. $1\frac{1}{2}$ B.O. & $1\frac{1}{2}$ BWPH-3 hrs.
6000 acid. Swb. 393 B.O. 9
hrs. after load.
Gravity 18.5/76

10/6 6" @ 3429'.
Sil. 3422' (Corrected)
T.D. 3460' H.F.W.
P.B. 3364'.
Perforated casing 3260-3268 &
3225-28'.
6000 acid.
Pump 268.94 bbls. 4 hrs &
253 bbls. 4 hrs.
Potential 1519 bbls.

COMPLETED

Ellis KANSAS

Map No. _____ Sec. 18 Twp. 14 R. 16WWell No. 1-PhillipBuffalo Oil Company

FIRST REPORT Contractor

SECTION PLAT

			0

330 Ft. from N. Line

_____ Ft. from S. Line

330 Ft. from E. Line

_____ Ft. from W. Line

Location _____

Rig up _____

Drilling and Remarks:

P.R.

RECORD

Cased _____ in., _____ ft.

Sand _____

Gas _____

Oil _____

Total Depth _____

PRODUCTION

1st 24 hrs. Nat. _____

1st 24 hrs. after shot _____

Gas _____ Cu. Ft.

Dry Hole _____

Abandoned _____

Date

AUG 25 1937 19

H. D. Hatfield

Scout

Ellis

KANSAS

Map No. _____ Sec. 18 Twp. 14 R. 16WWell No. 1 PhillipBuffalo Oil Company

Contractor _____

COMPLETED

NE/C

330 Ft. from N. Line

_____ Ft. from S. Line

330 Ft. from E. Line

_____ Ft. from W. Line

SECTION PLAT

			0

Location _____

Rig up _____

Drilling and Remarks:

P.B. 3364
 Perforated casing
 3260-3268 & 3225-28
 6000 Acid
 P- 268.94/4 & 253/4
 Pot- 1519

RECORDCased 6 in., 3429 ft.Sand sil 3422Gas (corrected)

Oil _____

Total Depth 3460 H.F.W.**PRODUCTION**

1st 24 hrs. Nat. _____

1st 24 hrs. after shot _____

Gas _____ Cu. Ft.

Dry Hole _____

Abandoned _____

Date

OCT - 6 1934H. D. Hatfield Scout