


Section 18 Township 14 Range 14W

Well No. #1 Carrol

Company Skelly

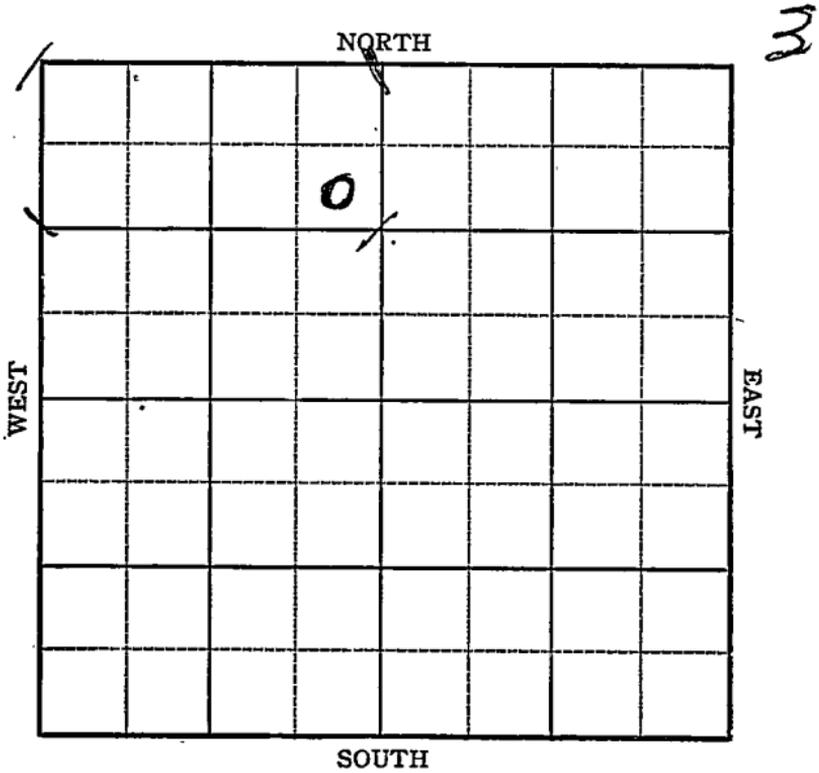

Sec. 18 Twp. 14 R. 14W

Well No. #1 Carrol Farm
Skelly Company

Williamson Pool


990 Ft. from N. Line

_____ Ft. from S. Line

330 Ft. from E. Line

_____ Ft. from W. Line

4/26, 1872

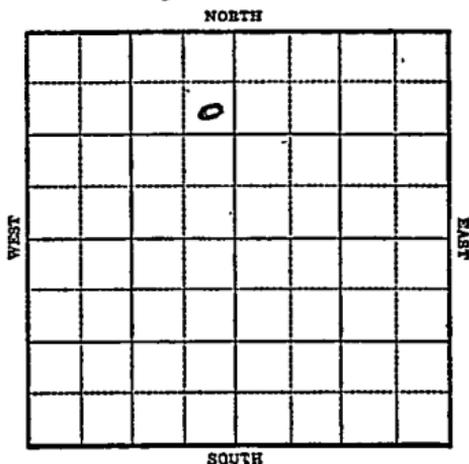

1944

R E P O R T

- 3/1 Location
- 3/8 "
- 3/16 Rotary
- 3/22 "
- 3/29 "
- 4/5 "
- 4/12 "
- 4/19 "
- 4/26 Anhy 872
10" @ 879
WOC.
- 5/3 Drlg. 2285
- 5/10 Topeka 2758
SO 2942-49
Dodge 2995
Lans SO 3041-46
305 9-61 3070-74
Drlg. 3090'
- 5/17 Sdy Cong. 3301-32 T.D.
5" - 3330 RUST
- 5/24 " " "
- 5/31 " " "
- 6/7 " " "

OVER

1944

6/15 PB 3282 69 shots 3136-52
Sw. 1/2 water pe' hr trace oil
4 hrs.

6/21 78 shots 3058-78
3750 acid Pump 12 oil and 42 wtr in
24 hrs.

6/28 PB 3078 WOC

7/19 5" @ 3330
Cong. Sdy 3301
TD 3332'

ABANDONED

Pool Name Williamson
KANSAS
 Map No. 72 Sec. 18 Twp. 14 R. 14W
 Well No. 1 Carrol

Skelly

Company

ABANDONED

Contractor

SE NE NW

SECTION PLAT

990 Ft. from N. Line

_____ Ft. from S. Line

330 Ft. from E. Line

_____ Ft. from W. Line

	o		

Russell County

Location _____

Rig up _____

Drilling and Remarks:

Comp July 3301
333325

RECORD

Cased _____ in., _____ ft.

Sand _____

Gas _____

Oil _____

Total Depth 3332

PRODUCTION

1st 24 hrs. Nat. _____

1st 24 hrs. after shot _____

Gas _____ Cu. Ft.

Dry Hole _____

Abandoned _____

Date

JUL 1 9 1944 19

S. J. LEWIS Scout

Misc. Small Maps

Oma

Cards

Left

Tracing

MEL

ance Map

MEL

orough Map

MEL

Map

MEL

al Dept.

Moody Plat Book

KANSAS

Map No. 72 Sec. 18 Twp. 14 R. 14W

Well No. 1 Carrol

Skelly Company

FIRST REPORT Contractor

SE NE NW

SECTION PLAT

990 Ft. from N. Line

_____ Ft. from S. Line

330 Ft. from E. Line

_____ Ft. from W. Line

Williamson Pool

Location X

Rig up _____

Drilling and Remarks:

RECORD

Cased _____ in., _____ ft.

Sand _____

Gas _____

Oil _____

Total Depth _____

PRODUCTION

1st 24 hrs. Nat. _____

1st 24 hrs. after shot _____

Gas _____ Cu. Ft.

Dry Hole _____


Abandoned _____

Date

MAR 1 1944 19

S. J. LEWIS

Scout

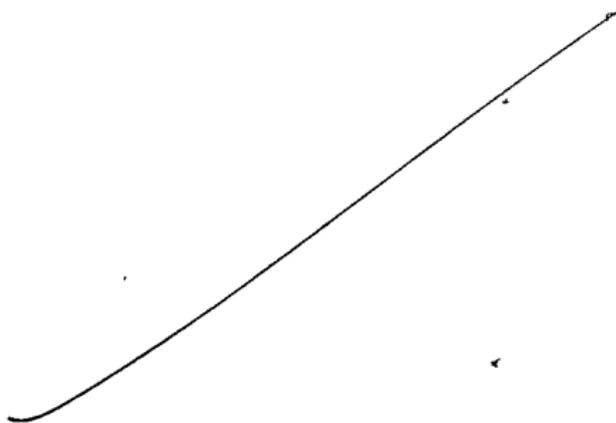

Misc. Small Maps	<i>Anna</i>
Cards	<i>Madge</i>
Tracing	<i>ME 2</i>
France Map	<i>[Signature]</i>
Scarborough Map	<i>[Signature]</i>
Woody Map	<i>ME 2</i>
Biological Dept.	
Woody Plat Book	