

Russell

FORM 51 IOM 12-46 PETROL

KANSAS

Section 18 Township 14 Range 14-W

Well No. ~~#2~~ Carroll

Company Alva Billings

Hall-Gurney NORTH

6

			0				

WEST

EAST

SOUTH

KANSAS Russell county

Sec. 18 Twp. 14 R. 14W

Well No. 2. Carroll Farm

Alva Billings Company

Hall-Gurney Pool

Ft. from N. Line


990

Ft. from S. Line

330

Ft. from E. Line

Ft. from W. Line

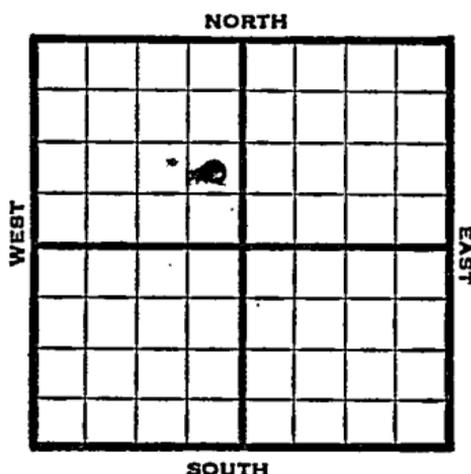

NE SE NW

1947

Elev. 1870' REPORT

6/25

Location

7/1

"

7/8

"

7-16

Rig

7/22

"

7/29

"

8/6

"

8/13

"

8/20

"

8/27

"

9/3

"

9/10

"

9/17

Drlg. 140'

9/24

Drlg. 690'

10/1

13" @ 540'
Anhydrite 378'

10" @ 885'

Drlg. 1825'

10/8

8" @ 2530'

Drlg. 2540'

OVER

1947

10/15 Lansing 3025'
Drlg. 3065'

10/22 7" @ 3029'
TD 3150'
PB 3040'

11/5 Lans. 3025'
7" @ 3029'
Pump 30 oil & 18 W Pot
Gr. 40°
Total Depth 3057'
COMPLETED

Map No. 72 Sec. 18 Twp. 14 R. 14W

Well No. 2 Carroll

Alva Billings Company

CORRECTION Contractor

NE SE NW

_____ Ft. from N. Line

990 Ft. from S. Line

330 Ft. from E. Line

_____ Ft. from W. Line

Russell County

SECTION PLAT

	o		

Location _____

Rig up _____

Drilling and Remarks:

Reported as
#1 Carroll

RECORD

Cased _____ in., _____ ft.

Sand _____

Gas _____

Oil _____

Total Depth _____

PRODUCTION

1st 24 hrs. Nat. _____

1st 24 hrs. after shot _____

Gas _____ Cu. Ft.

Dry Hole _____

Abandoned _____

Date

OCT 29 1947 19

S. J. LEWIS

Scout

Misc. Small Maps 2

Cards Eddie

Tracing 15

France Map ✓

Scarborough Map 1

Pierce Map 15

Geological Dept

Pierce Field Book

Map No. _____ Sec. 18 Twp. 14 R. 14W

Well No. 1 Carroll

Alva Billings Company

FIRST REPORT Contractor

NE SE NW


SECTION PLAT

_____ Ft. from N. Line

990 Ft. from S. Line

330 Ft. from E. Line

_____ Ft. from W. Line

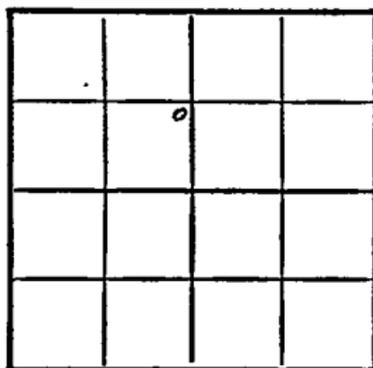

Russell County

Location X

Rig up _____

Drilling and Remarks:

RECORD

Cased _____ in., _____ ft.

Sand _____

Gas _____

Oil _____

Total Depth _____

PRODUCTION

1st 24 hrs. Nat. _____

1st 24 hrs. after shot _____

Gas _____ Cu. Ft.

Dry Hole _____


Abandoned _____

Date

JUN 25 1947 19

S. J. LEWIS Scout

TABLE

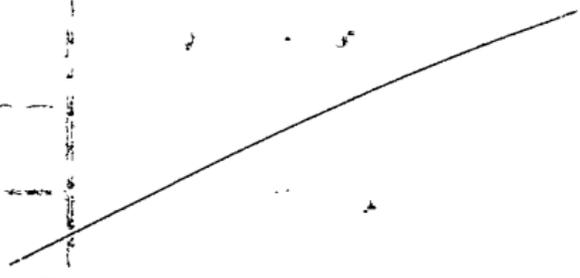

- Misc. Small Maps
- Cards
- Tracing
- France Map
- Scarborough Map
- Pierce Map
- Geological Dept.
- Pierce Plat Book

Kansas

Map No. 72 Sec. 18 Twp. 14 R. 14WWell No. 2 CarrollAlva Billings

Company

COMPLETE

Contractor

NE SE NW

E11870

SECTION PLAT

 Ft. from N. Line990 Ft. from S. Line330 Ft. from E. Line Ft. from W. Line

	o		

Russell CountyLocation Rig up

Drilling and Remarks:

Lease 30257" C08029Pump 30 oil + 18WBJ40 3/4

RECORD

Cased in., ft.Sand Gas Oil Total Depth 3057

PRODUCTION

1st 24 hrs. Nat. 1st 24 hrs. after shot Gas Cu. Ft.Dry Hole Abandoned

Date

NOV 5 1947 19S. J. LEWIS

Scout

[Handwritten scribble]

Misc. Small Maps	<i>[Handwritten mark]</i>
Cards	<i>[Handwritten mark]</i>
Tracing	<i>[Handwritten mark]</i>
France Map	<i>[Handwritten mark]</i>
Scarborough Map	<i>[Handwritten mark]</i>
Fierce Map	<i>[Handwritten mark]</i>
Ecological Dept.	
to Flat Book	