


Section 18 Township 14 Range 14-W

Well No. #3 Carroll

Company Phillips Pet.

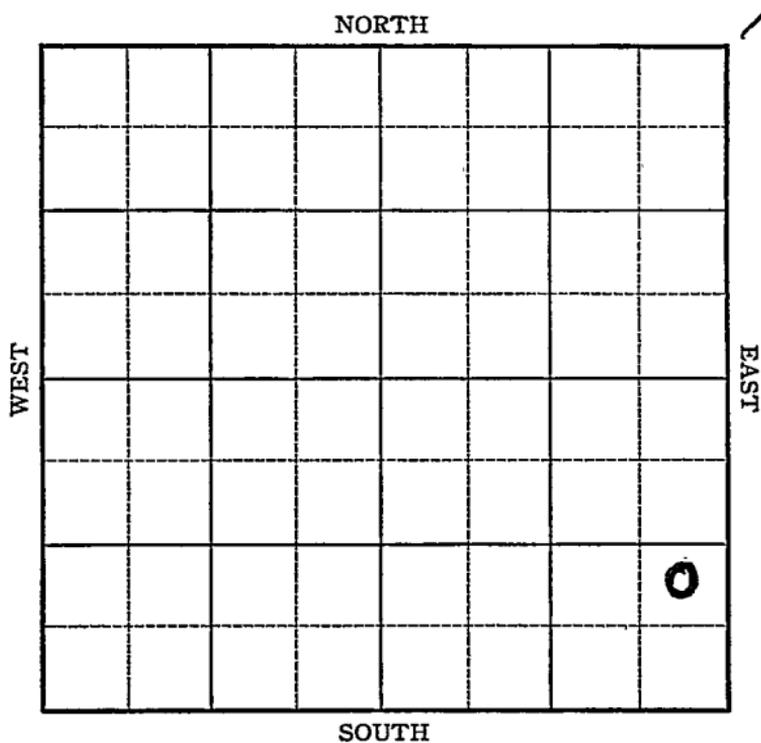

Sec. 18 Twp. 14 R. 14W

Well No. 3-Carroll Farm


Phillips Pet. Company

_____ Ft. from N. Line

990 Ft. from S. Line

330 Ft. from E. Line

_____ Ft. from W. Line

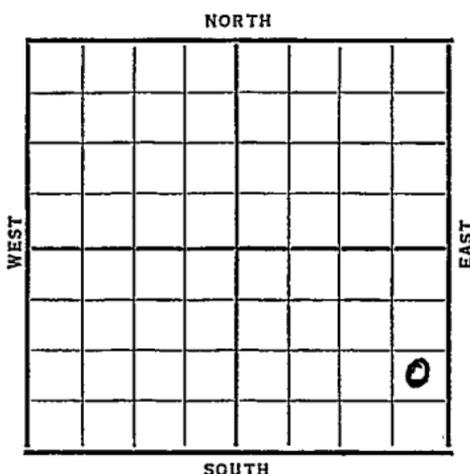

Elev. 1880

Date	REPORT
1937	
8/11	B.R.R.
8/20	10" @ 608'. Drl g. 1000'.
8/28	Drl g. 2935'.
9/3	K.C. 3013 & 7".
	T.D. 3025'. 1800' oil.
9/10	T.D. 3045'. Swab 93 B.O. in
	1½ hrs.
9/15	7" @ 3013'
	KC 3013'
	TD 3045'
	4000 acid
	P&F 419/4 & 370/4
	Pot 2339
	COMPLETED

Russell **KANSAS**

Map No. _____ Sec. 18 Twp. 14 R. 14 W

Well No. 3-Carroll

Phillips Pet Company
Contractor

FIRST REPORT

SECTION PLAT

_____ Ft. from N. Line
990 Ft. from S. Line
330 Ft. from E. Line
_____ Ft. from W. Line

			0

Location _____

Rig up _____

Drilling and Remarks:

B.R.R.

RECORD

Cased _____ in., _____ ft.
Sand _____
Gas _____
Oil _____
Total Depth _____

PRODUCTION

1st 24 hrs. Nat. _____
1st 24 hrs. after shot _____
Gas _____ Cu. Ft.
Dry Hole _____
Abandoned _____

Date

AUG 11 1937

H. D. Hatfield Scout

Russell KANSAS

Map No. _____ Sec. 18 Twp. 14 R. 14WWell No. 3-CarrollPhillips Pet Company

Contractor _____

COMPLETED

_____ Ft. from N. Line

990 Ft. from S. Line330 Ft. from E. Line

_____ Ft. from W. Line

SECTION PLAT

			0

Location _____

Rig up _____

Drilling and Remarks:

4000 andAF - 419/4 + 370/4pot - 2339

RECORD

Cased 7 in., 3013 ft.Sand KC 3013

Gas _____

Oil _____

Total Depth 3045

PRODUCTION

1st 24 hrs. Nat. _____

1st 24 hrs. after shot _____

Gas _____ Cu. Ft.

Dry Hole _____

Abandoned _____

Date

SEP 15 1937 19H. D. Hatfield

Scout