

Section 18 Township 14 Range 14W

Well No. #1 Carroll

Company J. W. Braden

NORTH

13

0							

WEST

EAST

SOUTH

Russell

KANSAS  
14W

Sec. 18 Twp. 14 R. 14W ✓

Well No. #1 Carroll Farm

J.W. Braden Company

Braden Drlg. Contractor

Big Creek Pool


         Ft. from N. Line

330' Ft. from S. Line

         Ft. from E. Line

330' Ft. from W. Line

SW SW SW

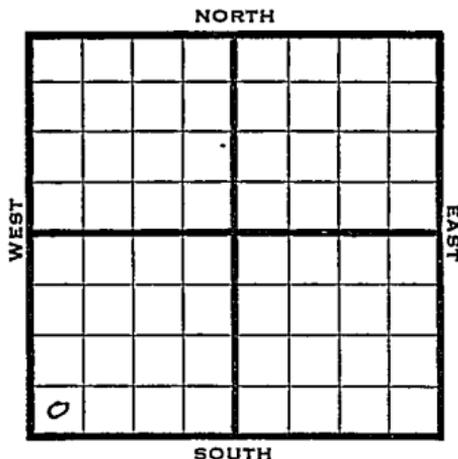

1950 <sup>2</sup>lev. 1856' REPORT

4/19 Location

5/31  
 8" @ 531'  
 Topeka 2679'  
 Heeb. 2967'  
 Toronto 2985'  
 Lans. 3026'  
 5" @ 3282'  
 TD 3284'  
 FU 800' oil in 14 hr.  
 PB 3085'  
 23/3051-57  
 1000 A  
 FU 350' oil  
 4000 A  
 Swab 75 BOPD 50 % wtr  
 Comp. 60 BOPD

**COMPLETED**

Map No. \_\_\_\_\_ Sec. 18 Twp. 14 R. 14W

Well No. 1 Carroll

J. W. Braden \_\_\_\_\_ Company

Bradén Drlg. \_\_\_\_\_ Contractor

SW SW SW


## SECTION PLAT

\_\_\_\_\_ Ft. from N. Line

330 Ft. from S. Line

\_\_\_\_\_ Ft. from E. Line

330 Ft. from W. Line

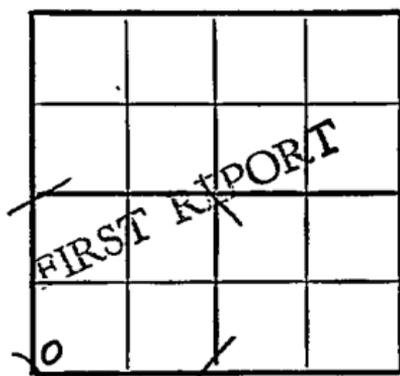

Russell County

Location X

Rig up \_\_\_\_\_

Drilling and Remarks:

## RECORD

Cased \_\_\_\_\_ in., \_\_\_\_\_ ft.

Sand \_\_\_\_\_

Gas \_\_\_\_\_

Oil \_\_\_\_\_

Total Depth \_\_\_\_\_

## PRODUCTION

1st 24 hrs. Nat. \_\_\_\_\_

1st 24 hrs. after shot \_\_\_\_\_

Gas \_\_\_\_\_ Cu. Ft.

Dry Hole \_\_\_\_\_

Abandoned \_\_\_\_\_

Date

APR 19 1950 19 J. E. TYRA Scout

Scout Cards  
Land Small Map  
Land Wall Map  
Tracings  
France Map  
Pica-a-Map  
Misc

SECTION 1


Scout Cards  
Land Small Map  
Land Wall Map  
Tracings  
France Map  
Pica-a-Map  
Misc

FLOOR

Scout Cards  
Land Small Map  
Land Wall Map  
Tracings  
France Map  
Pica-a-Map  
Misc

APR 21 1950

Scout Cards	
Land Small Map	
Land Wall Map	3
Tracings	
France Map	
Pica-a-Map	
Misc	

Map No. \_\_\_\_\_ Sec. 18 \_\_\_\_\_ Twp. 14 \_\_\_\_\_ R. 14W \_\_\_\_\_

Well No. 1 Carroll \_\_\_\_\_

J. W. Braden \_\_\_\_\_ Company \_\_\_\_\_

\_\_\_\_\_ Contractor

SW SW SW


E1.1856  
SECTION PLAT

\_\_\_\_\_ Ft. from N. Line

330 \_\_\_\_\_ Ft. from S. Line

\_\_\_\_\_ Ft. from E. Line

330 \_\_\_\_\_ Ft. from W. Line

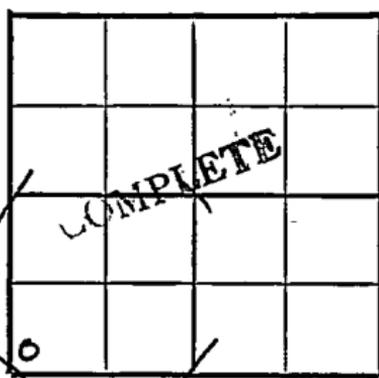

Russell

Location \_\_\_\_\_

Rig up \_\_\_\_\_

Drilling and Remarks:

8" C 531

Zopaka 2679

Keeb. 2967

Toronto 2985

Lans. 3026

Arb. 3270

5" C 3282

## RECORD

Cased \_\_\_\_\_ in., \_\_\_\_\_ ft.

Sand \_\_\_\_\_

Gas \_\_\_\_\_

Oil \_\_\_\_\_

Total Depth 3284

## PRODUCTION

1st 24 hrs. Nat. \_\_\_\_\_

1st 24 hrs. after shot \_\_\_\_\_

Gas \_\_\_\_\_ Cu. Ft.

Dry Hole \_\_\_\_\_

Abandoned \_\_\_\_\_

Date

MAY 31 1950 19

J. F. TYRA Scout

T.D. 3284

74 800' oil in 14 hr.

PQ 3085

23/ 3051-57

1000 A

74 350' oil

4000 A

Swab 75 lpsd 50% water

Comp. 60 lpsd

Misc.
Pierce Map
France Map
Tracings
Land Wall Map
Land Small Map
Scout Cards

1950 6

11022

11022