


Section 18 Township 14 Range 14-W

Well No. 4 - Carroll

Company Phillips Pet.

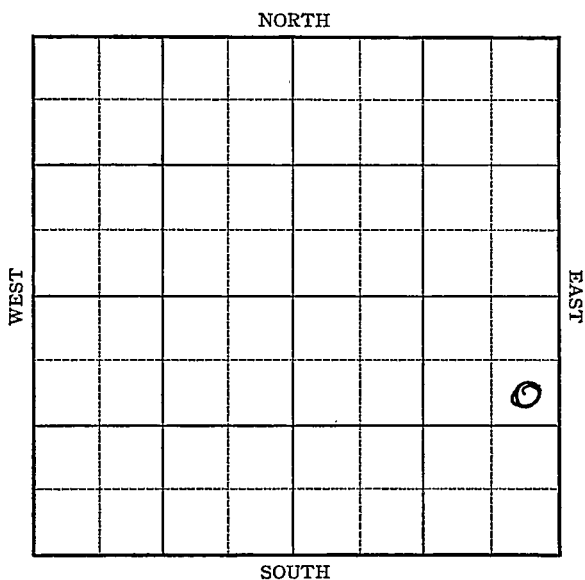

9

Sec. 18 Twp. 14 R. 14-W

Well No. #4 Carroll Farm
Phillips Pet. Company


990 Ft. from N. Line

_____ Ft. from S. Line

330 Ft. from E. Line

_____ Ft. from W. Line

Elev. 1882

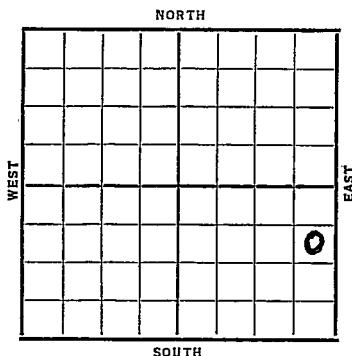

Date	REPORT
1937	
9/8	Location
9/17	"
9/24	R O G
10/2	10" @ 613'. WOC.
10/8	Drlg. 2622'.
10/15	Oswald 3020'. 7" @ 3043' T.D.
	WOC.
10/22	T.D. 3070'. 2200' oil.
10/27	7" @ 3043'.
	Oswald 3020'.
	T.D. 3070'.
	4000 acid.
	P. 405 bbls. 4 hrs & 391.7 bbls.
	4 hrs.
	Potential 2350 bbls.
	COMPLETED

Map No. _____ Sec. 18 Twp. 14 R. 14W

Well No. 4-Carroll

Phillips pet Company

Contractor _____

FIRST REPORT

990 Ft. from N. Line

_____ Ft. from S. Line

330 Ft. from E. Line

_____ Ft. from W. Line

SECTION PLAT

			0

Location

Rig up _____

Drilling and Remarks:

RECORD

Cased _____ in., _____ ft.

Sand _____

Gas _____

Oil _____

Total Depth _____

PRODUCTION

1st 24 hrs. Nat. _____

1st 24-hrs. after shot _____

Gas _____ Cu. Ft.

Dry Hole _____

Abandoned _____

Date

SEP 8 1937 19

H. D. Hatfield

Scout

Russell

KANSAS

Map No. _____ Sec. 18 Twp. 14 R. 14W

Well No. 4 Carroll

Phillips

Company

Contractor

COMPLETED

SE NE SE

990 Ft. from N. Line

_____ Ft. from S. Line

330 Ft. from E. Line

_____ Ft. from W. Line

SECTION PLAT

			0

Location _____

Rig up _____

Drilling and Remarks:

4000 acid

P-405/4 + 391.7/4

POT-2350

RECORD

Cased 7 in., 304 3/4 ft.

Sand Oswald 3020

Gas _____

Oil _____

Total Depth 3070

PRODUCTION

1st 24 hrs. Nat. _____

1st 24 hrs. after shot _____

Gas _____ Cu. Ft.

Dry Hole _____

Abandoned _____

Date

OCT 27 1937

19

H. D. Hatfield

Scout