


Russell

KANSAS

Section 18 Township 14 Range 14-W

Well No. 1 Carrie

Company Phillips

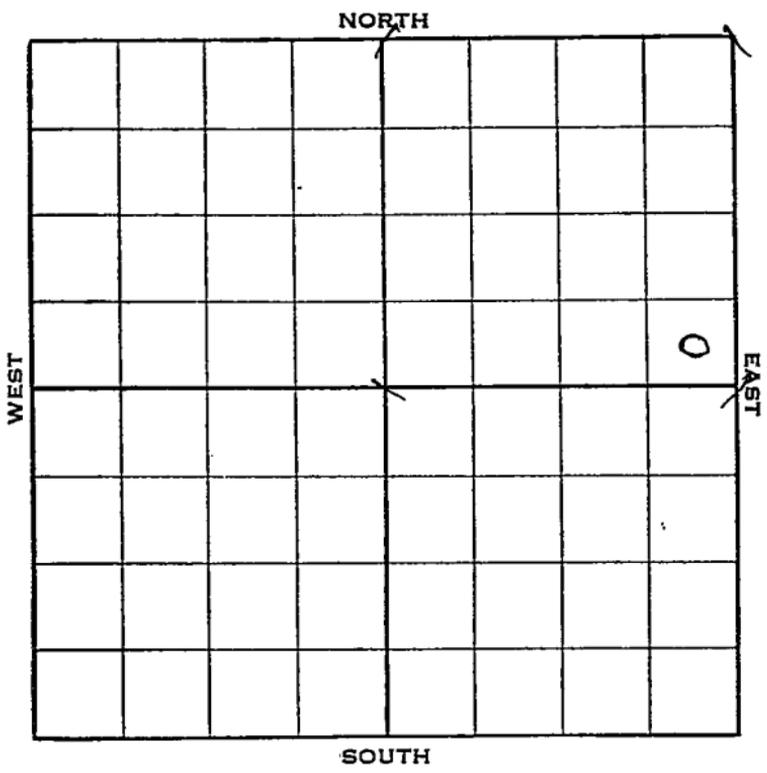

Sec. 18 Twp. 14 R. 14-W

Well No. #1 Carrie Farm


Phillips Company

_____ Ft. from N. Line

330 Ft. from S. Line

330 Ft. from E. Line

_____ Ft. from W. Line

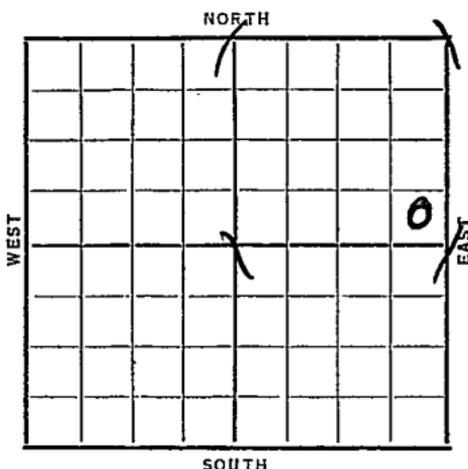

Elev. 1885

Date	REPORT
1938	
2/16	B.R.R.
2/26	R U R
3/4	10" @ 619'. WOC.
3/11	Drlg. 2970'.
3/18	K.C. 3044'. T.D. 3071' S.O.
	7" @ 3069'. WOC.
3/25	T.D. 3100'. Good S.O.
	Testing.
4/1	" "
4/8	T.D. 3097' (Corrected)
	On potential.
4/13	7" @ 3069'.
	K. C. 3044'.
	T.D. 3097'.
	4000 acid.
	Potential 86 oil, 5% water.
	COMPLETED

Map No. _____ Sec. 18 Twp. 14 R. 14WWell No. 1 CarriePhillips Company


Contractor _____

FIRST REPORT**SE NE**

_____ Ft. from N. Line

330 Ft. from S. Line330 Ft. from E. Line

_____ Ft. from W. Line

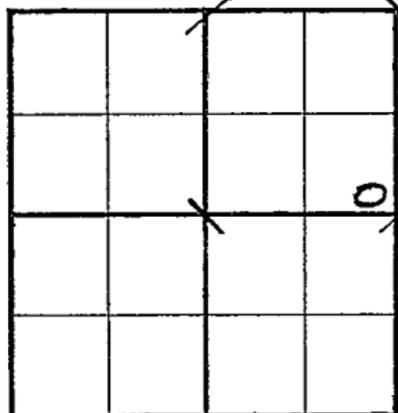SECTION PLAT

Location _____

Rig up _____

Drilling and Remarks:

BRR**RECORD**

Cased _____ in., _____ ft.

Sand _____

Gas _____

Oil _____

Total Depth _____

PRODUCTION

1st 24 hrs. Nat. _____

1st 24 hrs. after shot _____

Gas _____ Cu. Ft.

Dry Hole _____

Abandoned _____

Date

FEB 16 1938 19H. D. Hatfield Scout

Russell KANSAS

Map No. 72 Sec. 18 Twp. 14 R. 14WWell No. 1 CarriePhillips

Company

Contractor

COMPLETED

SE NE

 Ft. from N. Line330 Ft. from S. Line330 Ft. from E. Line Ft. from W. Line**SECTION PLAT**

			0

Location Rig up

Drilling and Remarks:

4000 acidPot 86 oil
590 wtr**RECORD**Cased 7 in., 3069 ft.Sand KC 3044Gas Oil Total Depth 3097**PRODUCTION**1st 24 hrs. Nat. 1st 24 hrs. after shot Gas Cu. Ft.Dry Hole Abandoned

Date

APR 13 1938 19H. D. Hatfield Scout