


KANSAS

Section 18 Township 14 Range 14W

Well No. #3 Carrie

Company Phillips

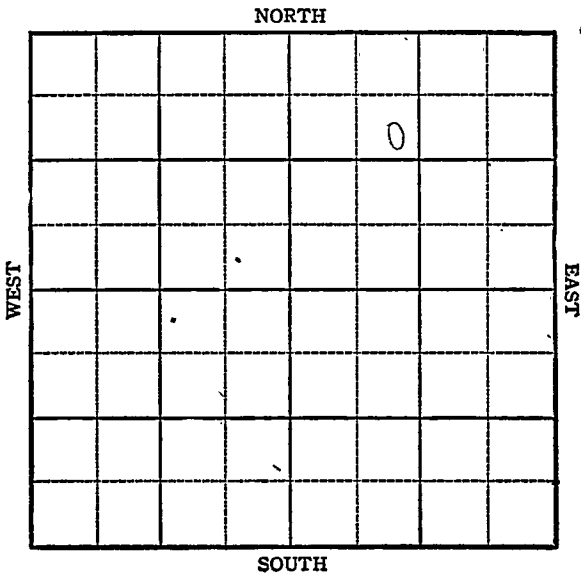

Sec. 18 Twp. 14 R. 14W

Well No. #3 Carrie Farm

Phillips Company


Williamson

990 Ft. from N. Line

_____ Ft. from S. Line

_____ Ft. from E. Line

990 Ft. from W. Line

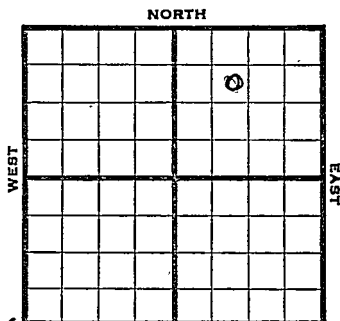

SE NW NE *Elev. 1869*

1944

R E P O R T

12/6 10" @ 629'
Drlg. 1066'

12/14 Drlg. 1160'

12/21 Drlg. 2614

12/29 Lans 3036
SO 3063-3066
5" @ 3063
TD 3067
Must

1945
1/3 TD 3069 - 500 acid
SO

1/10 3160 fsg

1/17 Cong 3304
Arb 3305
Reagan 3313
TD 3320 1850' water PB

1/24 Arb. 3305
Reagan 3313
5" @ 3063
TD 3320

ABANDONED

Pool Name WilliamsonMap No. 72 Sec. 18 Twp. 14 R. 14WWell No. 3 CarriePhillips Company

FIRST REPORT

Contractor

SE NW NE

SECTION PLAT

990 Ft. from N. Line Ft. from S. Line Ft. from E. Line990 Ft. from W. Line

Russell

Location _____

Rig up _____

Drilling and Remarks:

10" $\frac{1}{2}$ 629

1066

RECORD

Cased _____ in., _____ ft.

Sand _____

Gas _____

Oil _____

Total Depth _____

PRODUCTION

1st 24 hrs. Nat. _____

1st 24 hrs. after shot _____

Gas _____ Cu. Ft.

Dry Hole _____

Abandoned _____

Date

DEC 6 1944 19

S. J. LEWIS Scout

Pool Name WilliamsonMap No. 72 Sec. 18 Twp. 14 R. 14WWell No. 3 CarriePhillips CompanyABANDONED Contractor

SE NW NE

SECTION PLAT

990 Ft. from N. Line

_____ Ft. from S. Line

_____ Ft. from E. Line

990 Ft. from W. Line

		o	

Russell

Location _____

Rig up _____

Drilling and Remarks:

Cor X 3305
Reagan 3313
5-33063

RECORD

Cased _____ in., _____ ft.

Sand _____

Gas _____

Oil _____

Total Depth 3320

PRODUCTION

1st 24 hrs. Nat. _____

1st 24 hrs. after shot _____

Gas _____ Cu. Ft.

Dry Hole _____

Abandoned _____

Date

JAN 24 1945 19S. J. LEWIS Scout