

19

14S

24W

SECTION _____ TOWNSHIP _____ RANGE _____


#1 Kline

WELL NO. _____

Bennett & Roberts

COMPANY _____

NORTH

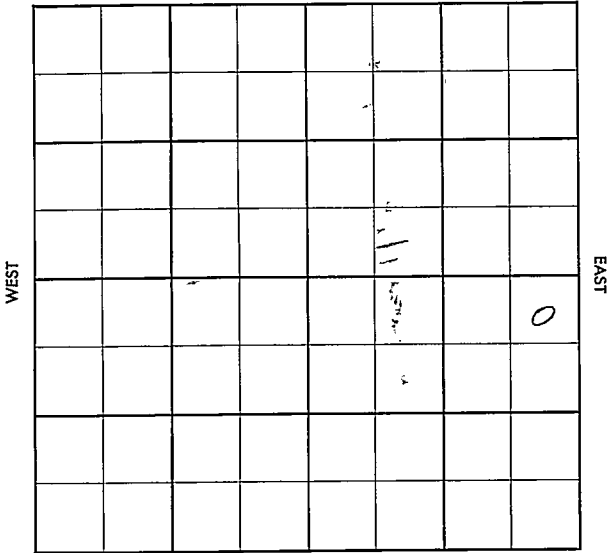

SOUTH

Trego

KANSAS

SEC. 19

TWP. 14S

R. 24W


WELL NO. #1 Kline

FARM

COMPANY Bennett & Roberts

CONTRACTOR

_____ FT. FROM N. LINE
_____ FT. FROM S. LINE
_____ FT. FROM E. LINE
_____ FT. FROM W. LINE

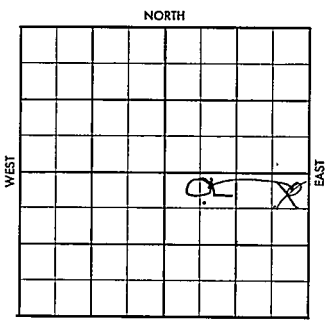

~~C 1/2 NW-SE~~
~~NE NE SE~~

SDX- 3/4 mile

Phillips (DHM)

1956 ELEVATION 2345 REPORT

6-13 Spud 6-8-56
8" @ 196 w/150
Drlg. 1925

6-21 Heeb 3641
ø 3730

6-27 DST-4187-4204 1 hr rec 270' MW 1075/20
H. 3641; L. 3664; B.K.C. 3889; M. 4186
V. 4346; A. 4452
TD. 4515
Log Tops:
H. 3564; Tr. 3580; L. 3603; B.K.C. 3879
Marm. 3904; Ce. 4115; M. 4187; Cg 4164;
V. 4346; A. 4459
D & A

ABANDONED

County Traso Elev. _____
 Sec. 19 Twp. 14S Rge. 24W
 Company Bennett & Roberts
 Farm Name Kline No. 7

TOPS	DEPTH	LOG	DATUM
Anb.			
Ip.			
H.			
Tr.			
Dg.			
Bl.			
L.			
K.C.			
B.K.C.			
Ce.			
C.			
M.			
M.			
K.			
Mz.			
Mq.			
V.			
S.			
S.			
A.			
R.			
Pe.			
G.			
T.D.			

Loc. in Sec. NE NE SE
 Geol. _____
 Contr. _____
 Pool _____
 W.C. _____

3/11/56
FIRST REPORT
JUN 13 56

Date Comm. Spud 6/8/56 Phillips (DHM)
8" 196 w/150, D 1925

2201 O S WUL

R.G.

Co.
Lse.
No.
Sec.
T.
R.

CORRECTION

FORM 513 SUNRAY

County Trego Elev. 2345
 Sec. 19 Twp. 11S Rge. 21W
 Company Bennett Roberts
 Farm Name Kline No. 1

	DEPTH	LOG	DATUM
M.	3641	3564	
Tr.		3580	
Dg.			
Bl.			
L.	3664	3603	
K.C.			
B.K.C.	3889	3879	
Ce. <u>Marm</u>		3904	
C.e.		4115	
M.	4186	4187	
M. <u>cg</u>		4164	
K.			
Mz.			
Mo.			
V.	4346	4346	
S.			
S.			
A.	4452	4459	
R.			
PE.			
G.			
T.D.	4515		

Loc. in Sec.

~~NE NE SE~~
GN/2 NW SE

Geol.

Contr.

Pool

W.C.

ABANDONED

JUN 27 '56

Date Comm. Spud 6/8/56 Phillips (DPM)

8" 796 w/150, D 1925 JUN 20 '56

1" 3730 JUN 27 '56 DST 4187-4204

1 hr sec 270' MW 1675/20

DEA

Co.

Use.

No.

Sec.

T.

R.