



*Trigo*

Map No. KANSAS Sec. 19 Twp 14 R. 24<sup>W</sup>

Well No. 1 H. F. Kline Farm


Mid-Kansas Company

\_\_\_\_\_ Ft. from N. Line

330 Ft. from S. Line

\_\_\_\_\_ Ft. from E. Line

330 Ft. from W. Line

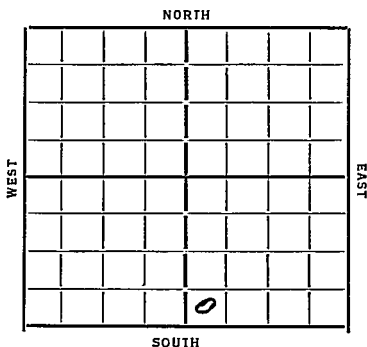

Date	REPORT
6/20	B. R.
6/28	Rign
7/5	dy 560
7/12	" 800
7/19	870 WR 15 1/2"
7/26	dy 1035
8/2	" 1240 " " " " 15" 1185
8/9	" 1910
8/16	" 2055
8/23	" 2790
8/30	" 3285 12" 2970
9/6	" 3420
9/13	" 3755
9/20	" 3882 HFW 3807 8" 3827
9/27	" 3950 Lansing 3827
10/4	WR 8" 4002
10/11	dy 4068 4050-9.5 HFW
10/18	" 4155 6" 4108
10/25	6" 4280
11/1	HFW 4385-4415 T) 4422 WR 6"
11/8	dy 4471 6" 4378 OVER

11/15 Miss L. 4402  
W.R. 6" 4615

11/22 Oly 4615 6" 4602

11/28 " 4702

12/6 " 4835

12/13 " 4936

12/21 " 5160

12/27 Granite Wash 5252

Oly 5328

1935

1/2 Granite Wash 5252

T.D. 5339

Dr. A.

ABANDONED



no wave

RPL

nut

✓

Map No. 69 Sec. 19 Twp. 14 R. 24W

Well No. 1-Kline

Mid-Kansas Company

Contractor

**ABANDONED**

**SECTION PLAT**

.....Ft. from N. Line

330 Ft. from S. Line

.....Ft. from E. Line

330 Ft. from W. Line

		0	

Location.....

Rig up.....

Drilling and Remarks:

*Granite wash  
5252'*

*W & H*

**RECORD**

Cased.....in., .....ft.

Sand.....

Gas.....

Oil.....

Total Depth 5339

**PRODUCTION**

1st 24 hrs. Nat.....

1st 24 hrs. after shot.....

Gas:.....Cu. Ft.

Dry Hole.....

Abandoned.....

Date

1-2-35 192.....

**ORVAL MANNSCHRECK**

Scout

no wall

PPS
MWS
<del>X</del>
B