


Section 19 Township 14 Range 29 W

Well No. # 1 Hockersmith

Company Argo Oil

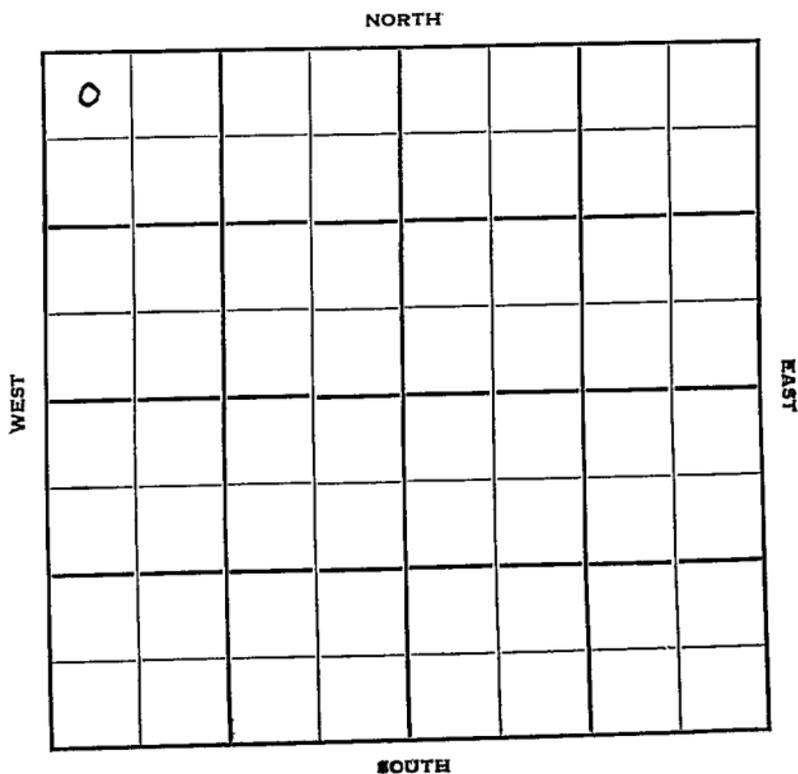

Gove

KANSAS

29W

Sec. 19

Twp.

14

R.

Well No. #1 Hoekersmith Farm

Argo Oil

Company

Wildcat

Contractor

330 Ft. from N. Line


Ft. from S. Line

330 Ft. from E. Line

Ft. from W. Line

NW NW NW

Sinc. & Atl. DHM

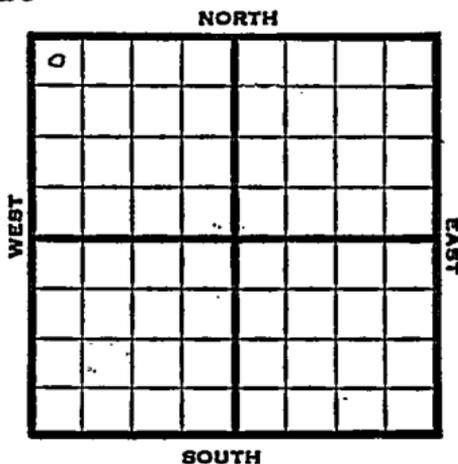

1951 Elev. 2629' REPORT

10/3
11/28

Location
 Spud 10-18-51
 D&A TD 4507
 10" @ 215
 Top. 3941 Heeb. 3615
 Lans. 3620 Marm. 3941
 DST 4135-61 open 1/2 hr.
 Rec. 840' mud 375' was gcm
 DST 4155-4212 open 1 hr.
 Rec. 1020' mud
 DST 4161-4222 open 1 hr. Rec. 655'
 mud Warsaw 4339 Osage 4344
 TD 4507
 D&A

ABANDONED

County Gove State Kansas

Sec. 19 (Blk. Twp.) 14 (Sur. Rge.) 29W Map No.

Operator Argo Oil

Well No. 1 Farm Hockersmith

Elev. _____ Location NW NW NW

0							
FIRST REPORT							

330 Ft. From N Line NW

330 Ft. From W Line Quarter

1st. Report OCT 3 1951


Completion _____

Remarks Sinc. & Atl. - DIM

Spudding Date _____

Drlg. Data Wildcat

Location _____

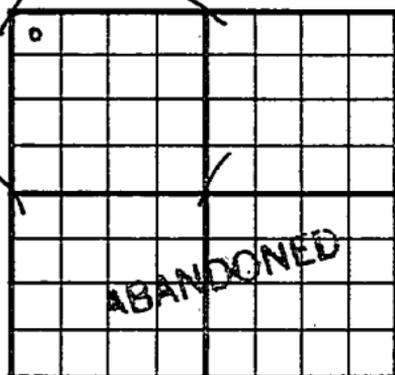County Gove State KansasSec. 19 (Blk. Twp.) 14 (Sur. Rge.) 29W Map No.Operator Argo OilWell No. 1 Farm HockersmithElev. 2629 Location NW NW NW330 Ft. From N Line NW330 Ft. From W Line Quarter

1st. Report

Completion NOV 28 1951Remarks WildeatNye Drlg. - Contr.Spudding Date 10-18-51Drlg. Data D & A TD 450710" @ 215 Top. 3361 Heeb. 3615Lans. 3620 Marm. 3941 DST 4135-61open 1/2 hr. Rec. 840' mud 375' was gomDST 4155-4212 open 1 hr. Rec. 1020' mudDST 4161-4222 open 1 hr. Rec. 655' mudWarsaw 4339 Osage 4344 TD 4507D & A

J. E. TYRA