

Sec. 19 Twp. 14 R. 14W


Well No. 2 Reinhardt Farm

Simon Lebow Company

Hall-Gurney Pool

Lebow-Contar

Ft. from N. Line

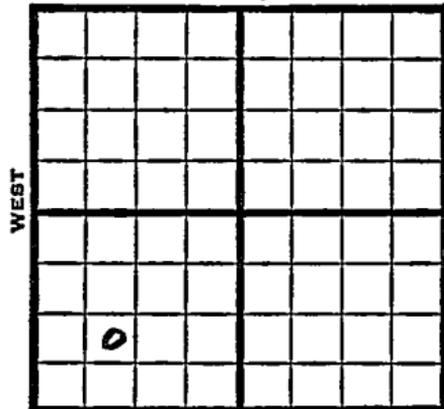

990 Ft. from S. Line

Ft. from E. Line

990 Ft. from W. Line

NE SW SW

SOUTH

1949 Elev. 1826' REPORT

9/28 Anhy 850
8" @ 855'

10/5 Drlg 1840'

10/12 Drlg 3139'

10/19 Lansing 2991'
Arb. 3232-41'
TD 3241'
5" @ 3239'

10/26 Arb 3232'
5" @ 3239'
250 acid
Pump 50 oil Pot.
Grav. 40.9
TD 3246'

COMPLETED

Map No. _____ Sec. 19 Twp. 14 R. 14W

Well No. 2 Reinhardt

Simon Lebow Company

Lebow Contractor

NE SW SW

FIRST REPORT
SECTION PLAT

_____ Ft. from N. Line

990 Ft. from S. Line

_____ Ft. from E. Line

990 Ft. from W. Line

	o		

Russell County

Location _____

Rig up _____

Drilling and Remarks:

Anhy 850
8" @ 855
.....
.....

RECORD

Cased _____ in., _____ ft.

Sand _____

Gas _____

Oil _____

Total Depth _____

PRODUCTION

1st 24 hrs. Nat. _____

1st 24 hrs. after shot _____

Gas _____ Cu. Ft.

Dry Hole _____

Abandoned _____

Date

SEP 28 1949 .19

S. J. LEWIS Scout

Kansas

Hall-Gurney Pool

Map No. _____ Sec. 19 Twp. 14 R. 14W

Well No. 2 Reinhardt

Simon Lebow

Company

COMPLETE

Contractor

NE SW SW

E. 1826
SECTION PLAT

_____ Ft. from N. Line

990 _____ Ft. from S. Line

_____ Ft. from E. Line

990 _____ Ft. from W. Line

6			

Russell County

Location _____

Rig up _____

Drilling and Remarks:

*CR 3232**5" @ 3232**2500 acid**Only 50 oil Prod**H. S. Lu*

RECORD

Cased _____ in., _____ ft.

Sand _____

Gas _____

Oil _____

Total Depth *3246*

PRODUCTION

1st 24 hrs. Nat. _____

1st 24 hrs. after shot _____

Gas _____ Cu. Ft.

Dry Hole _____

Abandoned _____

Date

OCT 26 1933

19

S. J. LEWIS

Scout