


Section 19 Township 14 Range 14-W

Well No. 5 Reinhardt "D"

Company National Refining

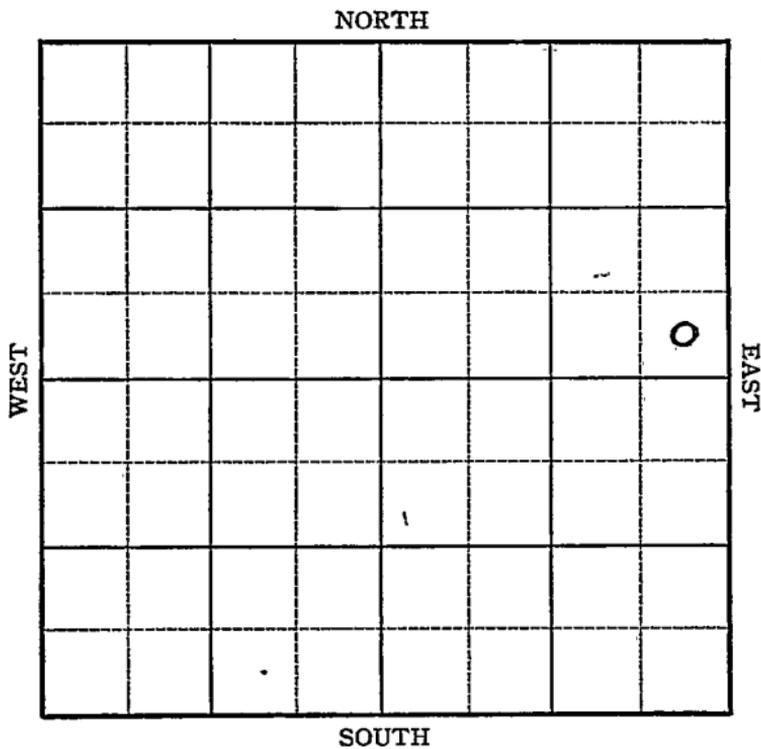

O. W. D. D

Sec. 19 Twp. 14 R. 14-W

Well No. #5 Reinhardt "D" Farm
National Refg. Company


 Ft. from N. Line

330 Ft. from S. Line

330 Ft. from E. Line

 Ft. from W. Line

Elev. 1854

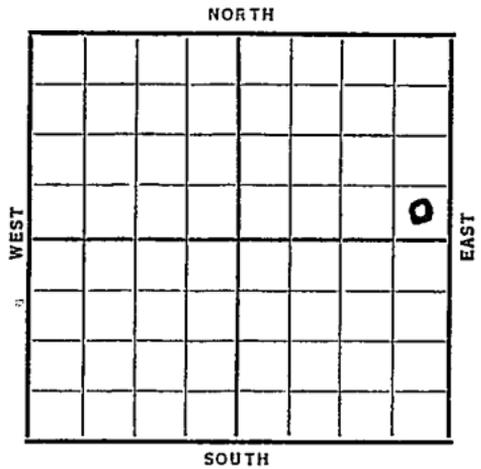

Date	REPORT O. W. D. D
1937	
12/22	Cellar.
12/31	"
1938	
1/7	Rig.
1/14	"
1/20	"
1/28	"
2/4	"
2/11	"
2/18	"
2/26	"
3/4	"
3/11	"
3/18	"
3/25	"
4/1	15" @ 385'. 12" @ 542'. Anhy 858'. 10" @ 867'. Dr lg. 1100'.
4/8	S.G. 1810'. Dr lg. 2025'.
4/15	8" @ 2225'. S.G. 2420'. Dr lg. 2445'.

OVER

1938

4/22 S.O. 2615-25 $\frac{1}{8}$. 8" @ 2503'.
Drlg. 2715'.

4/29 Topeka 2725' S.O. 2860'.
1 $\frac{1}{2}$ BW 2930'. K.C. 3026'.
6" @ 3028'. 2 bailers oil
per hour 3176-78'. U. R. 6".

5/6 6" @ 3172'. T.D. 3182' S.O.
2000 acid.

5/10 6" @ 3172'.
K.C. 3026'.
T.D. 3182'.
2000 acid.
Potential 930 oil & 27 water.

COMPLETED

1938


O. W. D. D

5/18 Old T.D. 3182'.
Old potential 930 oil & 27 wtr.
Oil exhausted. Set 7" @ 3182'.
Deepened.
Cong. 3259'.
Gorham 3278'.
T.D. 3289'. 109' of 5" liner
perforated on bottom.
2700' oil.
Potential 725 oil-no water.

FIRST REPORT

and

COMPLETED

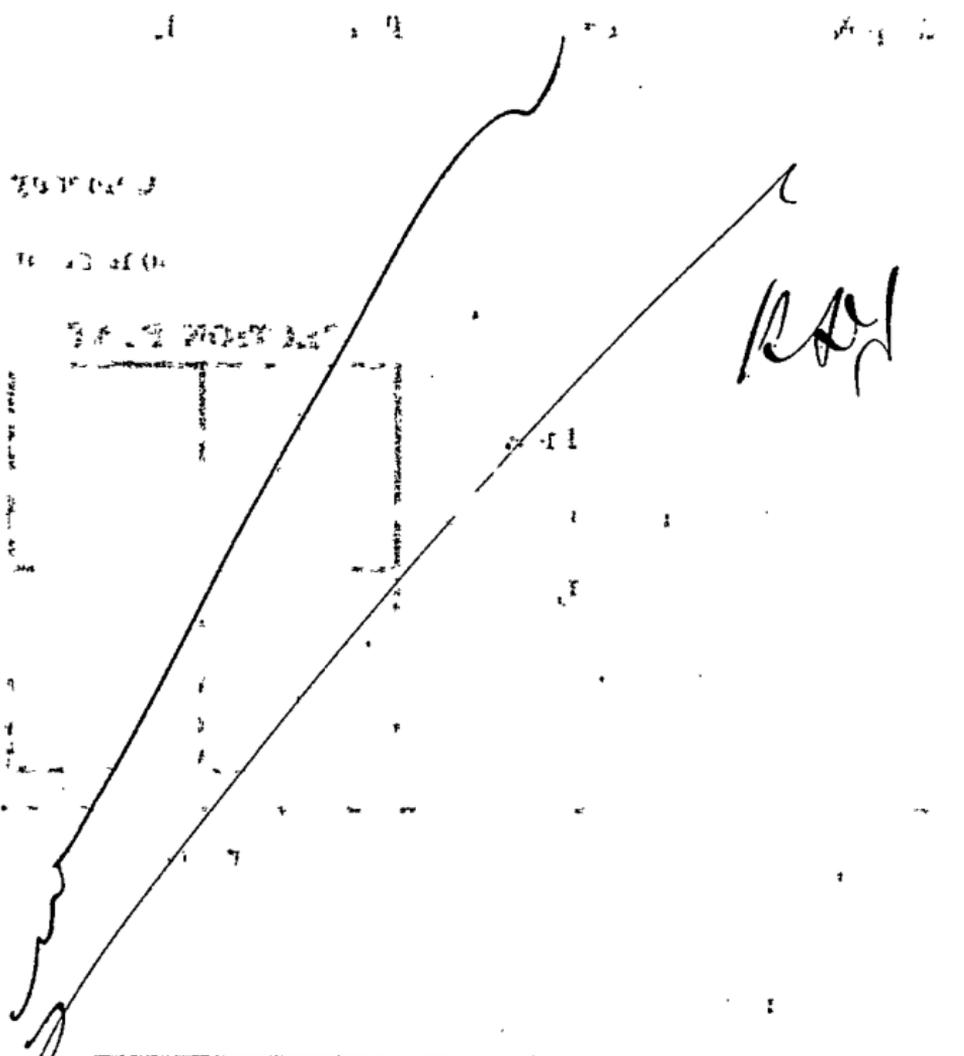

Paul

Returned	
Cards	<i>Paul</i>
Tracing	<i>Joe</i>
France Map	<i>✓</i>

Russell KANSAS

Map No. 72 Sec. 19 Twp. 14 R. 14WWell No. 5 Reinhardt "D"National Refining Company

Contractor

COMPLETED

SE NE

SECTION PLAT

 Ft. from N. Line330 Ft. from S. Line330 Ft. from E. Line Ft. from W. Line

			0

Location Rig up

Drilling and Remarks:

*2000 acid**pot 930 oil**27 wt*

RECORD

Cased 6 in. 3172 ft.Sand KC 3026Gas Oil Total Depth 3182

PRODUCTION

1st 24 hrs. Nat. 1st 24 hrs. after shot Gas Cu. Ft.Dry Hole Abandoned

Date

MAY 10 1938

19

H. D. Hatfield Scout

Ray

Returned
Cards	<i>Ray</i>
Tracing	<i>Ray</i>
France Map	<i>Ray</i>
Scarborough Map	<i>Ray</i>
Moody Map
Scarborough Plat Book
Moody Plat Book

Russell KANSAS

Map No. 72 Sec. 19 Twp. 14 R. 14W

Well No. 5 Reinhardt "D"

National Refining Company

FIRST REPORT

Contractor

COMPLETED

SECTION PLAT

SE NE
 _____ Ft. from N. Line
330 Ft. from S. Line
330 Ft. from E. Line
 _____ Ft. from W. Line

O. W. D. D.

Location _____

Rig up _____

Drilling and Remarks:

*OWDD - O.T.D. 3182
 old Pot. 930 oil. & 27 wt.
 oil exhausted. set 7" 3182
 deepened.
 Cong 3259
 Gorham 3278
 T.D. 3289 109' of 5" Line
 on bottom. 2700' oil
 Pot 725 oil - No wt.*

RECORD

Cased _____ in., _____ ft.

Sand _____

Gas _____

Oil _____

Total Depth _____

PRODUCTION

1st 24 hrs. Nat. _____

1st 24 hrs. after shot _____

Gas Perforated _____ Cu. Ft.

Dry Hole _____


Abandoned _____

Date

MAY 18 1938

19

H. D. Hatfield Scout

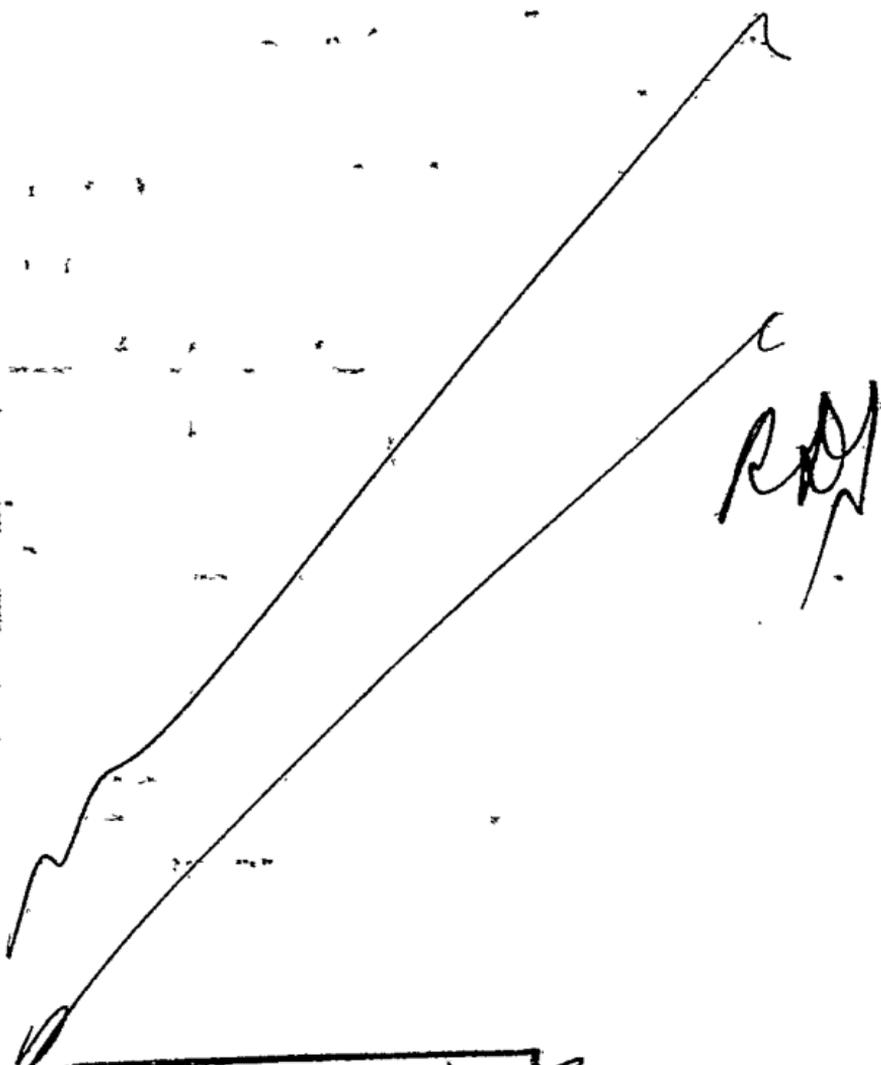

Returned	_____
Cards	_____ <i>Paul</i>
Tracing	_____ <i>Jim</i>
France Map	_____ <i>R. M. J.</i>
Scarborough Map	_____ <i>R. M. J.</i>
Moody Map	_____
Scarborough Plat Book	_____
Moody Plat Book	_____