


Section 19 Township 14 Range 14-W


Well No. 3 - Reinhardt "D"

Company National Refg.

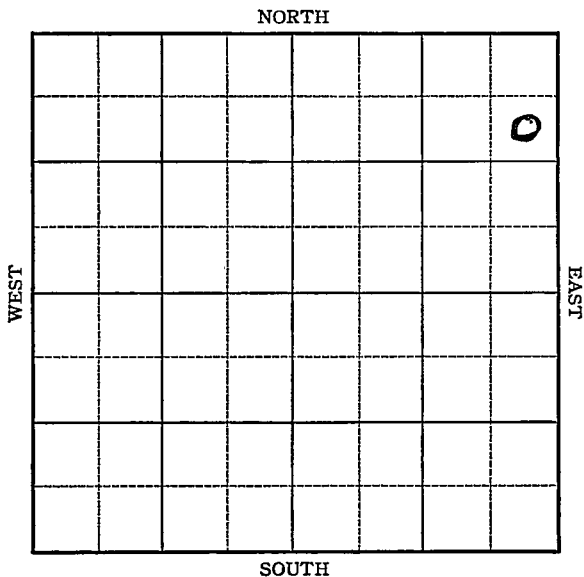

Sec. 19 Twp. 14 R. 14-WWell No. #3 Reinhardt FarmNational Ref. Company990 Ft. from N. Line Ft. from S. Line330 Ft. from E. Line Ft. from W. Line

Elev. 1869

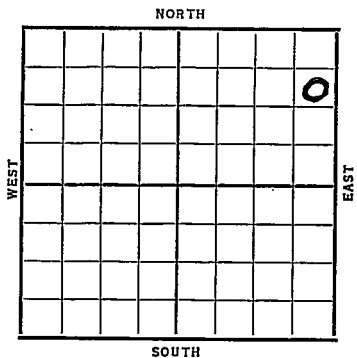

Date	REPORT
1937	
9/15	Cellar
9/24	R O G
10/2	R. U.
10/8	Spud.
10/15	15" @ 381'. 12" @ 555'.
	Anhy 856'. Drlg. 1825'.
10/22	10" @ 867'. S.G. 2045'.
	1 B.W.P.H. 2080-90'.
	S.G. 2415-25'. Drlg. 2480'.
10/29	Shows of gas 2595-2610,
	2720-25, 2972-75'.
	T.D. 3005'. SD for gsg.
11/5	H.F.W. 2972-75' in dodge.
	C.C. 3005'. 7" @ 3005'. WOC.
	OVER

1937

11/10 7" @ 3005'.

K.C. 3005'.

Pay 3045-54'.

T.D. 3055'.

Potential 1698 bbls. flow. Nat.

COMPLETED

Russell KANSAS

Map No. _____ Sec. 19 Twp. 14 R. 14^wWell No. 3- Reinhardt "D"National Ref. Company

Contractor

FIRST REPORT

SECTION PLAT

990 Ft. from N. Line

_____ Ft. from S. Line

530 Ft. from E. Line

_____ Ft. from W. Line

			o

Location _____

Rig up _____

Drilling and Remarks:

Cellar

RECORD

Cased _____ in., _____ ft.

Sand _____

Gas _____

Oil _____

Total Depth _____

PRODUCTION

1st 24 hrs. Nat. _____

1st 24 hrs. after shot _____

Gas _____ Cu. Ft.

Dry Hole _____

Abandoned _____

Date

SEP 15 1937 19H. D. Hatfield Scout

Ray

Returned _____

Cards *Ray* _____

Tracing *Ray* _____

France Map _____

Scarborough Map _____

Moody Map _____

Scarborough Plat Book _____

Moody Plat Book _____

Russell

Map No. _____ Sec. 19 Twp. 14 R. 14W

Well No. 3 Reinhardt "D"

National Refining Company

Contractor _____

COMPLETED

SE NE NE

990 Ft. from N. Line

_____ Ft. from S. Line

330 Ft. from E. Line

_____ Ft. from W. Line

SECTION PLAT

			0

Location _____

Rig up _____

Drilling and Remarks:

POT-1698
Flow
NAT.

RECORD

Cased 7 in., 3005 ft.

Sand K.C. 3005

Gas Pay 3045-54

Oil _____

Total Depth 3055

PRODUCTION

1st 24 hrs. Nat. _____

1st 24 hrs. after shot _____

Gas _____ Cu. Ft.

Dry Hole _____

Abandoned _____

Date

NOV 10 1937₁₉

H. D. Hatfield Scout

[Handwritten scribbles and a long diagonal line]

[Handwritten mark]

[Handwritten signature]

Returned	<i>[Signature]</i>
Cards	<i>[Signature]</i>
Tracing	<i>[Signature]</i>
Transcript	<i>[Signature]</i>
Examination	<i>[Signature]</i>
Book	<i>[Signature]</i>
Searchlight Book	
Maple Book	