


Russell

KANSAS

Section 19 Township 14 Range 14-W

Well Number 2- Reinhardt "D"

Company National

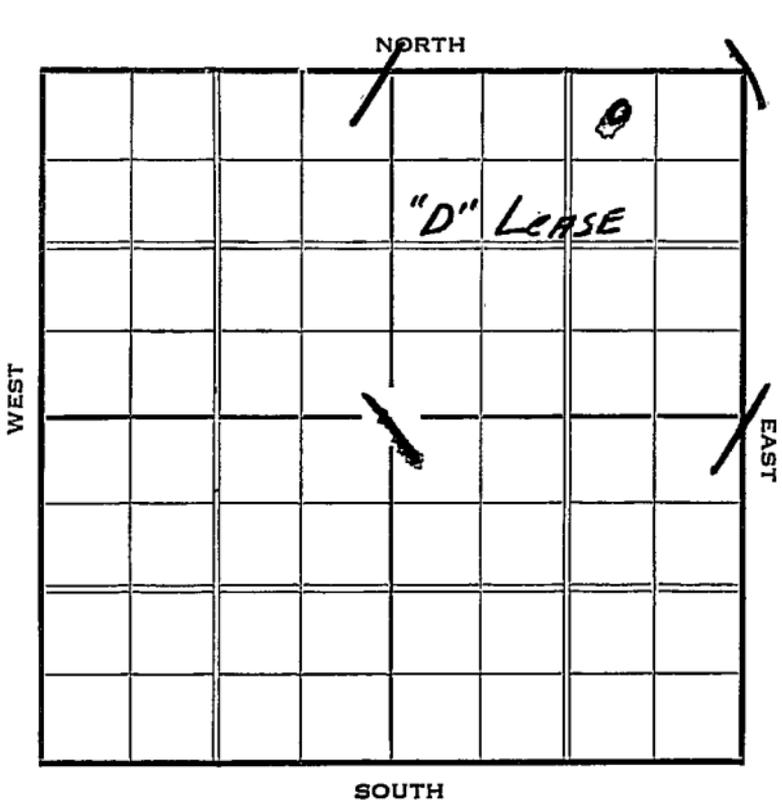


KANSAS Russell

Form 252-A-5M-7-36-Palace

Sec. 19 Twp. 14 R. 14-W

Well No. #2 Reinhardt "D" Farm
National Company

330 Ft. from N. Line
 _____ Ft. from S. Line
990 Ft. from E. Line
 _____ Ft. from W. Line

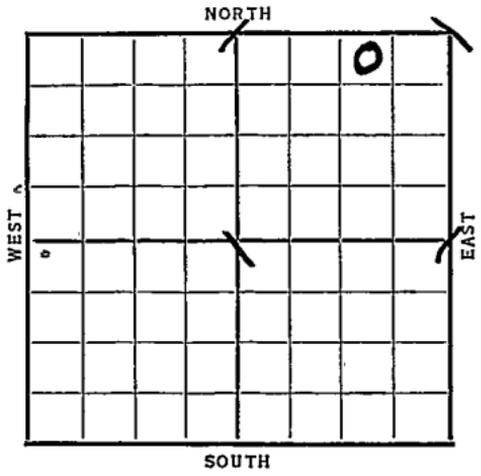

Elev. 1876

Date	REPORT
1937	
7/14	Location
7/23	"
7/30	"
8/6	B. R.
8/13	Spudd
8/20	15" @ 401'. 12" @ 575'. Drlg. 750'.
8/28	Anhy 859'. 10" @ 871'. Drlg. 1745'.
9/3	Drlg. 2405'.
9/10	8" @ 2540'. Drlg. 2835'.
9/17	Oswald 3035'. 7" @ 3036'. Show oil 3036-37 & 3041-43'. 1500' oil 1 hr. @ 3071'. H.F.O. @ 3075' T.D.
	OVER

1937

9/22

Oswald L. 3035'.

T.D. 3075'.

1611 bbls. Natural.

COMPLETED

KANSAS

Russell

Map No. _____ Sec. 19 Twp. 14 R. 14 W

Well No. 2. Reinhardt "D"

National Company

Contractor

FIRST REPORT

330 Ft. from N. Line

_____ Ft. from S. Line

990 Ft. from E. Line

_____ Ft. from W. Line

SECTION PLAT

		1	0
		"D"	
		Lse	
			1

Location

Rig up _____

Drilling and Remarks:

RECORD

Cased _____ in., _____ ft.

Sand _____

Gas _____

Oil _____

Total Depth _____

PRODUCTION

1st 24-hrs. Nat. _____

1st 24 hrs. after shot _____

Gas _____ Cu. Ft.

Dry Hole _____

Abandoned _____

Date

JUL 14 1937

19

H. D. Hatfield

Scout

RAY

Returned	<i>Paul</i>
Cards	<i>Paul</i>
Tracing	<i>Joe</i>
France Map	<i>RAY</i>
Scarborough Map	<i>RAY</i>
Moody Map	
Scarborough Plat Book	
Moody Plat Book	

Map No. _____ Sec. 19 Twp. 14 R. 14W

Well No. 2-Reinhart
National Company

Contractor _____

SECTION PLAT

330 Ft. from N. Line
1 Ft. from S. Line
990 Ft. from E. Line
_____ Ft. from W. Line

			0

COMPLETED

Location _____

Rig up _____

Drilling and Remarks:

1611 bbls
natural

RECORD

Cased _____ in., _____ ft.

Drill 7. 3035

Gas _____

Oil _____

Total Depth 3075

PRODUCTION

1st 24 hrs; Nat. _____

1st 24 hrs; after shot _____

Gas _____ Cu. Ft.

Dry Hole _____

Abandoned _____


Date

SEP 22 1937

19

H. D. Hatfield

Scout

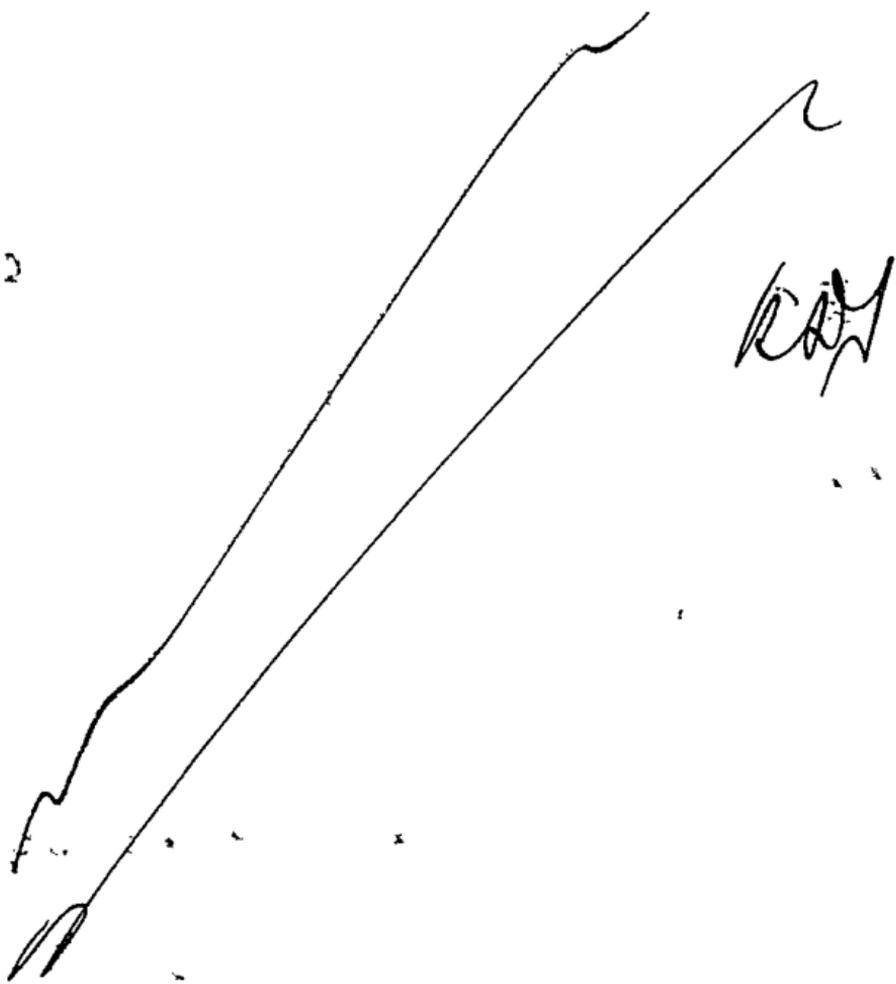

Returned	
Cards	<i>Paul</i>
Tracing	<i>Jim</i>
France Map	<i>✓</i>
Scarborough Map	<i>R. M.</i>
Moody Map	<i>✓</i>
Scarborough Plat Book	
Moody Plat Book	