

Section 19 Township 14 Range 14W

Well No. #5 Reinhardt

Company O R A

Big Creek Pool NORTH

//

WEST

EAST

		.					
			.				
		0					

SOUTH

Russell KANSAS

Sec. 19 Twp. 14 R. 14W

Well No. #5 Reinhardt Farm

C R A

Big Creek Pool (CRA, Contr.) Company


330' Ft. from N. Line

Ft. from S. Line

990' Ft. from E. Line

Ft. from W. Line

NW NE SW

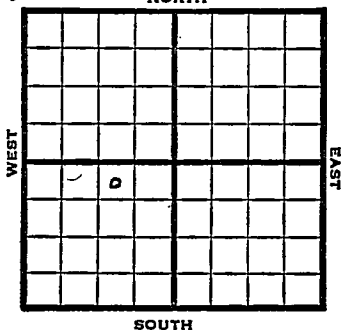

1949

Elev 1849' REPORT

12/14 Location

12/21 "

12/28 "

1950

2/15 TD 3265'
5" @ 3258'
Heeb 2956'
Lans 3014'
Reagan 3258'
P 36 BOPD
Comp

COMPLETED

Kansas

Map No. _____ Sec. 19 Twp. 14 R. 14WWell No. 5 Reinhardt

C R A

Company

C R A

Contractor

NW NE SW

FIRST REPORT
SECTION PLAT330 Ft. from N. Line Ft. from S. Line990 Ft. from E. Line Ft. from W. Line

	o		

Russell CountyLocation XRig up

Drilling and Remarks:

RECORD

Cased in., ft.Sand Gas Oil Total Depth

PRODUCTION

1st 24 hrs. Nat. 1st 24 hrs. after shot Gas Cu. Ft.Dry Hole Abandoned

Date

DEC 14 1949S. J. LEWIS

Scout

Map No. _____ Sec. 19 Twp. 14 R. 14W

Well No. 5 Reinhardt

C R A Company

Contractor

NW NE SW


E.I. 1849
SECTION PLAT

330 Ft. from N. Line

_____ Ft. from S. Line

990 Ft. from E. Line

_____ Ft. from W. Line

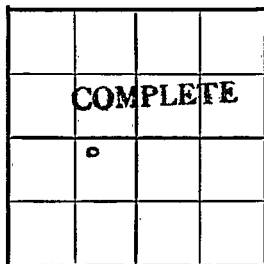

Russell County

Location _____

Rig up _____

Drilling and Remarks:

5" @ 3258
Hub 2956
Lans 3014
Ryan 3258
PB6 BOPD

RECORD

Cased _____ in., _____ ft.

Sand _____

Gas _____

Oil _____

Total Depth *3265*

PRODUCTION

1st 24 hrs. Nat. _____

1st 24 hrs. after shot _____

Gas _____ Cu. Ft.

Dry Hole _____

Abandoned _____

Date

FEB 15 1950 19

J. E. TYRA

Scout