

KANSAS

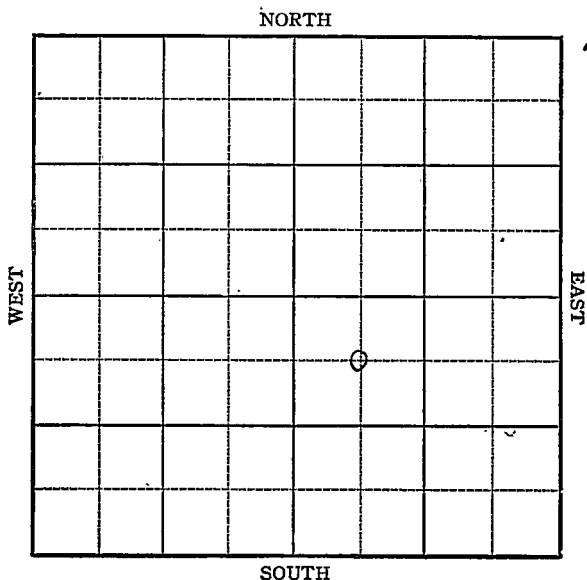
FORM 51 5M PETROL

Russell

Section 19 Township 14 Range 14-W

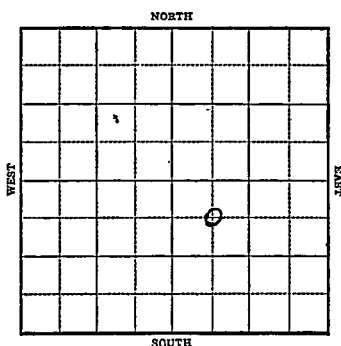
Well No. #3 Reinhardt

Company Gulf



KANSAS

Russell

Sec. 19 Twp. 14 R. 14-WWell No. #3 Reinhardt FarmGulf Company660 Ft. from N. Line Ft. from S. Line Ft. from E. Line660 Ft. from W. LineElev. 1858

1943

R E P O R T

10/27 Rotary

11/3 8" @ 668
Drlg. 1700'

11/10 Drlg. 3037'

11/17 Lanc. 3026

Arb. 3263-66

TD 5" @ 3264

RUST

11/24 TD 3271½ 1000 acid
Pump 45 fluid 24 hrs.

16% BS & water

12/1 PB 3226 11 shots 3025-31 no shows
13 shots 3063-69 SS&O & W
3000 acid

12/8 " "

12/15 5" @ 3264

Arb 3263

PB 3226

Lans 3026

13 shots 3063-69

3000 acid

Pump 66 Pot.

TD 3271½

Gravity 39.2

COMPLETED

KANSAS

Map No. 72 Sec. 19 Twp. 14 R. 14WWell No. 3 Reinhardt

Gulf

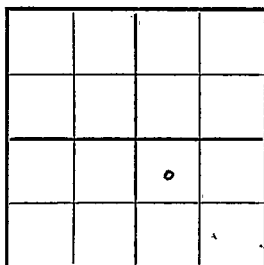
Company

FIRST REPORT

Contractor

C NW SE

SECTION PLAT

660 Ft. from N. Line Ft. from S. Line Ft. from E. Line660 Ft. from W. Line

Witt Pool

Location Rig up

Drilling and Remarks:

Rotary

RECORD

Cased in., ft.Sand Gas Oil Total Depth

PRODUCTION

1st 24 hrs. Nat. 1st 24 hrs. after shot Gas Cu. Ft.Dry Hole Abandoned

Date

OCT 27 1943 19S. J. LEWIS Scout

~~Map No. 72~~ Sec. 19 Twp. 14 R. 14W

Well No. 3 Reinhardt

Gulf

Company

COMPLETED

Contractor

C NW SE

SECTION PLAT

660 Ft. from N. Line

 Ft. from S. Line

 Ft. from E. Line

660 Ft. from W. Line

		0	

Witt Pool

Location

Rig up

Drilling and Remarks:

Car 83263

5" @ 3264

P.B. 3226 4mm. 3026

134 W to 3063 -69

3000 acid

Pump 66 P2X

392 421

RECORD

Cased in., ft.

Sand

Gas

Oil

Total Depth 327 1/2

PRODUCTION

1st 24 hrs. Nat.

1st 24 hrs. after shot

Gas Cu. Ft.

Dry Hole

Abandoned

Date

DEC 15 1943

19

S. J. LEWIS

Scout