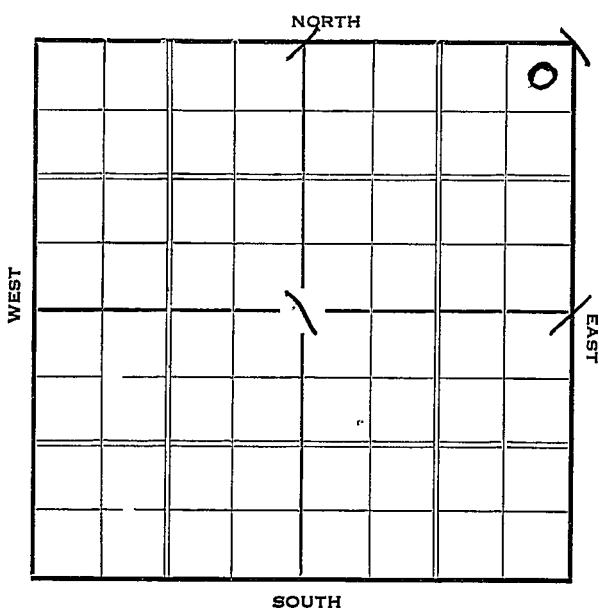


Section 19 Township 14 Range 14-WWell Number 1 H. Reinhardt "D"Company National Refg.

Sec. 19 Twp. 14 R. 14-WWell No. #1 H. Reinhardt "D" Farm

National Ref. _____ Company


330 Ft. from N. Line

_____ Ft. from S. Line

330 Ft. from E. Line

_____ Ft. from W. Line

Elev. 1872

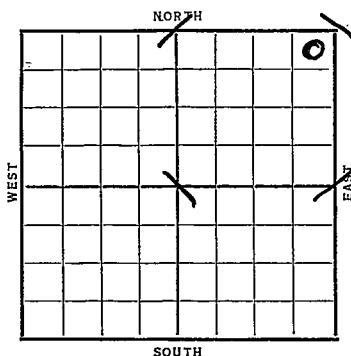

Date	REPORT
1937	
3/10	Location
3/18	" "
3/25	"
4/2	" "
4/8	" "
4/16	" "
4/23	"
4/30	Cellar
5/7	Rign. up.
5/14	15" @ 394'. C.O.
5/21	12" @ 856'. C.O.
5/28	S.G. 1845-50'. Drlg. 1870'.
6/4	S.G. 2395-2420'. 10" @ 2503
	Drlg. 2505'.
6/11	1 $\frac{3}{4}$ M gas & S.O. 2874-77'.
	K.G. 2971'. 8" @ 2972'.
	WOC.
6/19	Osw. 2971'. T.D. 2976'.
	Est. 4 M gas.
6/25	" " "
7/2	" " "
	OVER

1937

7/9 Osw. 2975' (Corrected)
T.D. 3023'. Flowed 1439 bbls.
in 24 hrs.
7/16 " "

7/21 Osw 2975' (corrected)
8" @ 2976'
TD 3023'
Pot 1439
Flowing

COMPLETED

KANSAS


Map No. 72 Sec. 19 Twp. 14 R. 14W

Well No. 1 H. Reinhardt

National Ref. Company

Contractor

SECTION PLAT

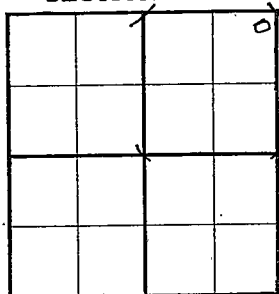

330 Ft. from N. Line

_____ Ft. from S. Line

330 Ft. from E. Line

_____ Ft. from W. Line

FIRST REPORT

Location ✓

Rig up _____

Drilling and Remarks:

RECORD

Cased _____ in., _____ ft.

Sand _____

Gas _____

Oil _____

Total Depth _____

PRODUCTION

1st 24 hrs. Nat. _____

1st 24 hrs. after shot _____

Gas _____ Cu. Ft.

Dry Hole _____

Abandoned _____

Date

MAR 10 1937₁₉

S. J. LEWIS Scout.

Ray

Returned	_____
Cards	_____
Tracing	_____
France Map	_____
Scarborough Map	_____
Moody Map	_____
Scarborough Plat Book	_____
Moody Plat Book	_____

Russell KANSAS

Map No. _____ Sec. 19 Twp. 14 R. 14^WWell No. 1 - Reinhardt "D"National Ref Company_____
Contractor

CORRECTION

330 Ft. from N. Line

____ Ft. from S. Line

330 Ft. from E. Line

____ Ft. from W. Line

SECTION PLAT

			0
		"D"	
		LSC	

Location _____

Rig up _____

Drilling and Remarks:

Was #1
Reinhardt

RECORD

Cased _____ in., _____ ft.

Sand _____

Gas _____

Oil _____

Total Depth _____

PRODUCTION

1st 24 hrs. Nat. _____

1st 24 hrs. after shot _____

Gas _____ Cu. Ft.

Dry Hole _____


Abandoned _____

Date

JUL 14 1937 1937

H. D. Hatfield.

Scout

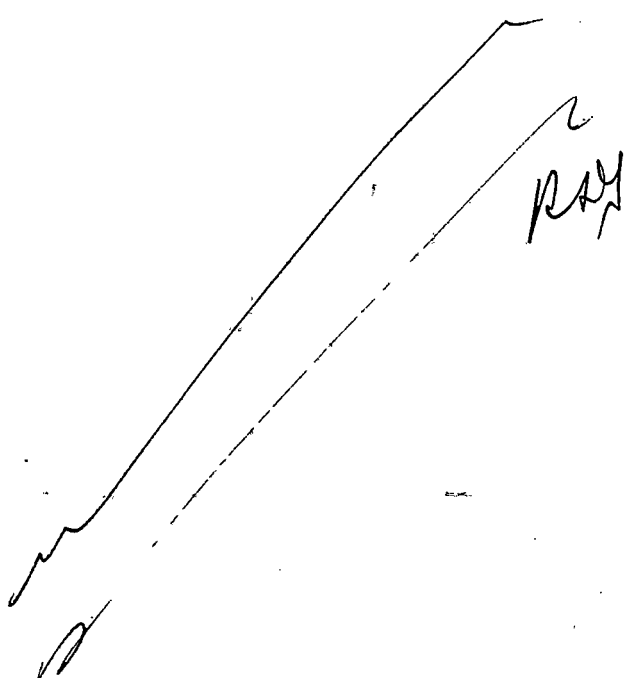

Returned	_____
Cards	_____
Tracing	_____
France Map	_____
Scarborough Map	_____
Moody Map	_____
Scarborough Plat Book	_____
Moody Plat Book	_____

Russell

Map No. 72 Sec. 19 Twp. 14 R. 14 WWell No. 1- Reinhardt "D"National Ref Company
Contractor

COMPLETED

330 Ft. from N. Line1 Ft. from S. Line330 Ft. from E. Line Ft. from W. Line

SECTION PLAT

			0

Location _____

Rig up _____

Drilling and Remarks:

Pot- 1439
flowing

RECORD.

Cased 8 in., 2976 ft.Sand OSW 2975Gas (Corrected)Oil Total Depth 3023

PRODUCTION

1st 24 hrs. Nat. 1st 24 hrs. after shot Gas Cu. Ft.Dry Hole Abandoned

Date

JUL 21 1937 19 H. D. Hatfield Scout

Returned

Cards

Trading

France Map

Scarborough Map

Moody Map

Scarborough Plat Book

Moody Plat Book