


Section 19 Township 14 Range 14W

Well No. #1 Mai

Company Chas. Trapp

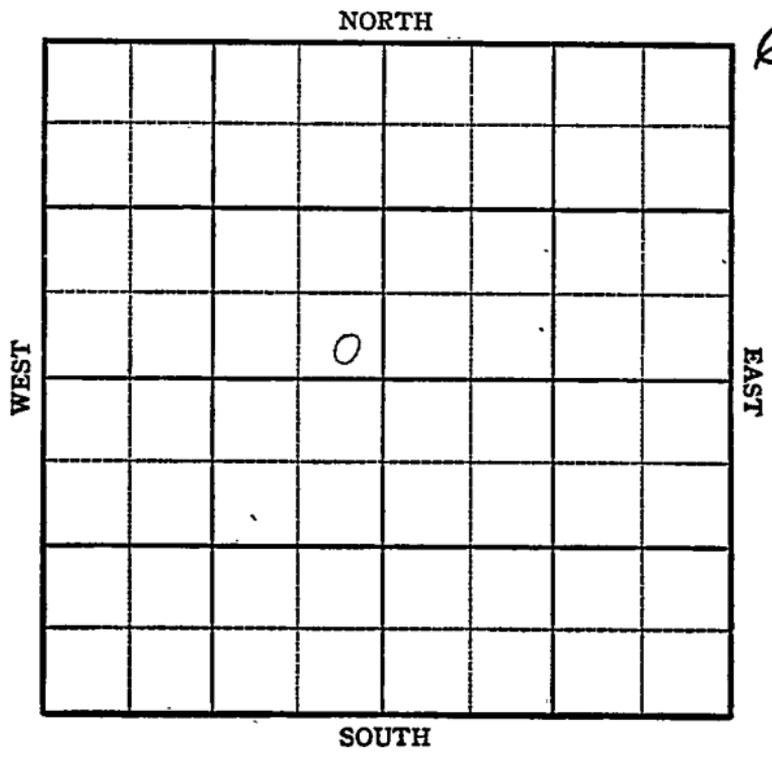


KANSAS Pool Name Williamson
 Map No. 72 Sec. 19 Twp. 14 R. 14 W
 Well No. 1 Mai

Chas. Trapp Company

FIRST REPORT Contractor

SE NW

SECTION PLAT

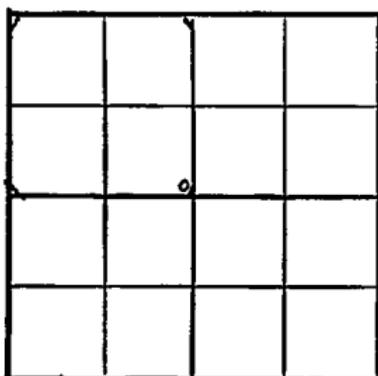

_____ Ft. from N. Line

330 Ft. from S. Line

330 Ft. from E. Line

_____ Ft. from W. Line

Russell County

Location _____

Rig up _____

Drilling and Remarks:

Cable

RECORD

Cased _____ in., _____ ft.

Sand _____

Gas _____

Oil _____

Total Depth _____

PRODUCTION

1st 24 hrs. Nat. _____

1st 24 hrs. after shot _____

Gas _____ Cu. Ft.

Dry Hole _____

Abandoned _____

Date

MAY 17 1944 19

S. J. LEWIS Scout

Pool Name Williamson

Map No. 7 KAR Sec. 19 Twp. 14 R. 14W

Well No. 1 Mai

Chas. Trapp Company

COMPLETED Contractor

SE NW

SECTION PLAT

 Ft. from N. Line

330 Ft. from S. Line

330 Ft. from E. Line

 Ft. from W. Line

Russell County

Location

Rig up

Drilling and Remarks:

Reagan 3269
700 3277
809 to 3080-95
Pump 20 ft
(273 ft)

RECORD

Cased in., ft.

Sand

Gas

Oil

Total Depth 3250

PRODUCTION

1st 24 hrs. Nat.

1st 24 hrs. after shot

Gas Cu. Ft.

Dry Hole

Abandoned

Date

AUG 9 1944 19

S. J. LEWIS Scout