

# KANSAS


Russell

FORM 51 5M 1-42 PETROL

Section 19 Township 14 Range 14-W

Well No. #1 Reinhardt

Company Phil-Han

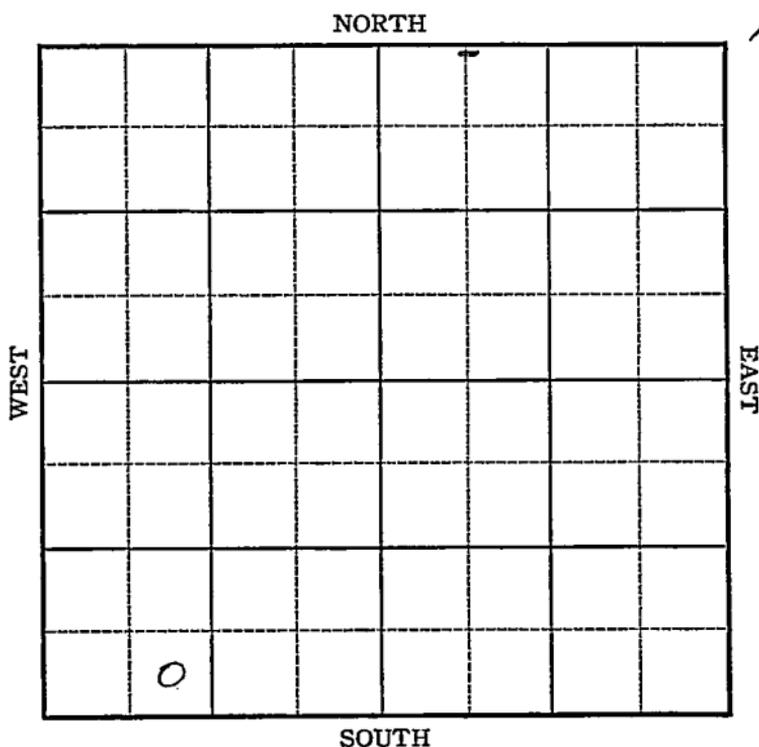

Sec. 19 Twp. 14 R. 14-W

Well No. #1 Reinhardt Farm

Phil-Han Company


Hall-Gurney

         Ft. from N. Line

330 Ft. from S. Line

         Ft. from E. Line

990 Ft. from W. Line

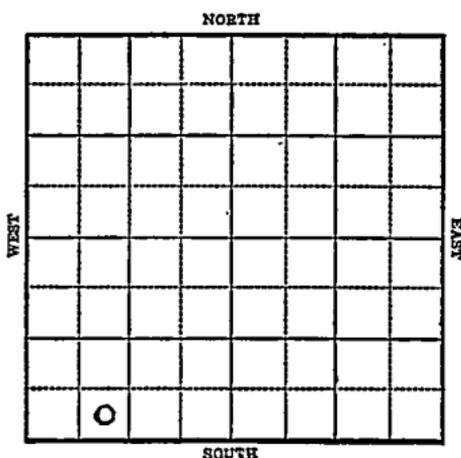

*Edw. 1817*

1943

R E P O R T

- 3/24 Cable
- 3/31 15" @ 41, 13" @ 390 10" @ 841  
Anhy 835 Drlg. 1370
- 4/7 2400 Run 8"
- 4/14 8" @ 2447  
Lans 2973  
T.D. 3002-600' oil in 2 hrs  
7" @ 2997 WOC.
- 4/21 T.D. 3004  
4179' oil-5000 acid.
- 4/28 Lans 2976  
7" @ 2997'  
T.D. 3004'  
5000 gal. acid  
Pump 903 Pot.  
Gravity 39

**COMPLETED**

**KANSAS**

**Russell**

Map No. 72 Sec. 19 Twp. 14 R. 14W

Well No. 1 Reinhardt

Phil-Han Company

**FIRST REPORT** Contractor

SE SW SW

SECTION PLAT

\_\_\_\_\_ Ft. from N. Line

330 Ft. from S. Line

\_\_\_\_\_ Ft. from E. Line

990 Ft. from W. Line


**HALL-GURNEY POOL**

Location \_\_\_\_\_

Rig up \_\_\_\_\_

Drilling and Remarks:

**Cable**

**RECORD**

Cased \_\_\_\_\_ in., \_\_\_\_\_ ft.

Sand \_\_\_\_\_

Gas \_\_\_\_\_

Oil \_\_\_\_\_

Total Depth \_\_\_\_\_

**PRODUCTION**

1st 24 hrs. Nat. \_\_\_\_\_

1st 24 hrs. after shot \_\_\_\_\_

Gas \_\_\_\_\_ Cu. Ft.

Dry Hole \_\_\_\_\_

Abandoned \_\_\_\_\_

Date

MAR 24 1943 19

**S. J. LEWIS** Scout

