

KANSAS

FORM 51 5M 1-42 PETROL

Russell

Section 19 Township 14 Range 14-W

Well No. #1 Reinhardt

Company National

NORTH

WEST

EAST

SOUTH

0

/

12

KANSAS

—Russell

Sec. 19 Twp. 14 R. 14-W

Well No. #1 Reinhardt Farm

National Company

Big Creek

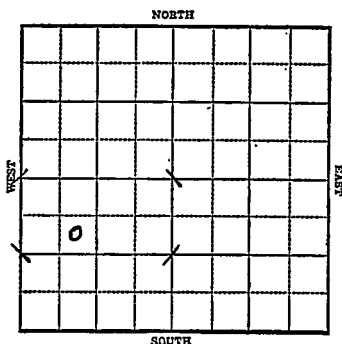
990 Ft. from N. Line

 Ft. from S. Line

 Ft. from E. Line

990 Ft. from W. Line

Elev. 1827



1943

R E P O R T

5/12 Rotary

5/19 Anhy 852
10" @ 863

5/26 Drlg. 1000'
Lans 2994-3000 T.D.
7" @ 3000' Rust.

6/2 " " "

6/9 T.D. 3021-1500' oil 5 hrs.

6/16 " " " "

6/23 10,000 acid

6/30 " " "

7/7 Lans 2994
7" @ 3000'
T.D. 3021'
1000 gal acid oil
Pump 935 Pot.
Gravity 32.7

COMPLETED

Russell

KANSAS

Map No. 2 Sec. 19 Twp. 14 R. 14WWell No. 1 Reinhardt

National

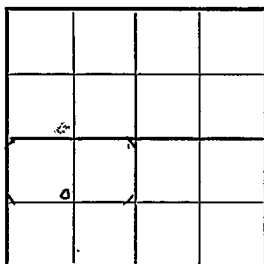
Company

FIRST REPORT

Contractor

SE NW SW

SECTION PLAT

990 Ft. from N. Line Ft. from S. Line Ft. from E. Line990 Ft. from W. Line

BIG CREEK POOL

Location

Rig up

Drilling and Remarks:

Rotary

RECORD

Cased in., ft.Sand Gas Oil Total Depth

PRODUCTION

1st 24 hrs. Nat. 1st 24 hrs. after shot Gas Cu. Ft.Dry Hole Abandoned

Date

MAY 1 2 1943 19

S. J. LEWIS

Scout

Russell

KANSAS

Map No. 72 Sec. 19 Twp. 14 R. 14 WWell No. 1 Reinhardt

National Refining

Company

COMPLETED

Contractor

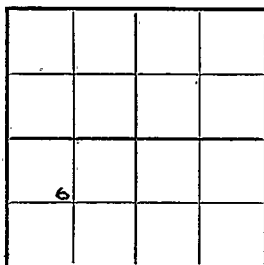
SE NW SW

SECTION PLAT

990 Ft. from N. Line

Ft. from S. Line

Ft. from E. Line

990 Ft. from W. Line

BIG CREEK POOL

Location

Rig up

Drilling and Remarks:

*Line 2994**7" @ 3000**10000 acid**Pump 935 P.D.**322 ft*

RECORD

Cased _____ in., _____ ft.

Sand _____

Gas _____

Oil _____

Total Depth 3021

PRODUCTION

1st 24 hrs. Nat. _____

1st 24 hrs. after shot _____

Gas _____ Cu. Ft.

Dry Hole _____

Abandoned _____

Date

JUL 7 1943 19

S. I. LEWIS Scout