

Russell KANSAS ✓

Sec. 19 Twp. 14 R. 14W

Well No. #5
#4 Rinehart Farm

Simon Lebow Company

Contractor

Big Creek Pool


Ft. from N. Line

330' Ft. from S. Line

Ft. from E. Line

990' Ft. from W. Line

SE SW SE

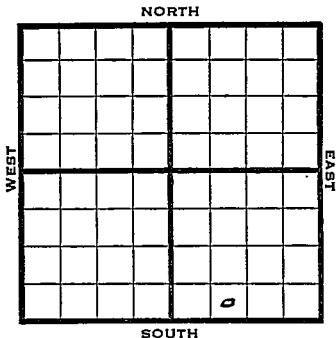

1950

REPORT

3/22
5/24

Location,
 Anhy 856-93
 10 3/4" @ 859
 Arb 3271
 7" @ 3351
 TD 3351
 12/3278-82
 8/3268-70
 500 acid
 swab 2 1/2 bo / 10 bwph
 Set plug 3175
 Perf. 3175
 3154-60
 3054-60
 3111-15
 3050-51
 3036-44
 3016-20 - Lans
 2972-77 - Dodge
 2762-67 - Topeka
 TD 3578
 comp swd
 Completed

COMPLETED

Kansas

Map No. _____ Sec. 19 Twp. 14 R. 14W

Well No. 4 Rinehart

Simon Lebow Company

Contractor

SE SW SE


SECTION PLAT

_____ Ft. from N. Line

330 Ft. from S. Line

_____ Ft. from E. Line

990 Ft. from W. Line

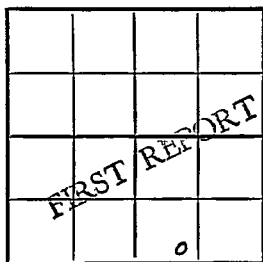

Russell County

Location X

Rig up _____

Drilling and Remarks:

RECORD

Cased _____ in., _____ ft.

Sand _____

Gas _____

Oil _____

Total Depth _____

PRODUCTION

1st 24 hrs. Nat. _____

1st 24 hrs. after shot _____

Gas _____ Cu. Ft.

Dry Hole _____

Abandoned _____

Date

MAR 22 1950 19

J. E. TYRA Scout

----- 11 ----- 35 -----

----- 1 -----













MAR 24 1950

Scout Cards	-----
Land Small Map	-----
Land Wall Map	-----
Tracings	-----
France Map	-----
Pierce Map	-----
Misc.	-----

Kansas

Map No. _____ Sec. 19 Twp. 14 R. 14WWell No. 5 RinehardtSimon Lebow

Company

Contractor

SE SW SE

E1.1839
SECTION PLAT

_____ Ft. from N. Line

330 Ft. from S. Line

_____ Ft. from E. Line

990 Ft. from W. Line

COMPLETE			
		o	

Russell

Location _____

Rig up _____

Drilling and Remarks:

any 856-93
103/4 C 859
arb. 3271
7" C 3351
T.D. 3351
12/ 3278-82
8/ 3268-70
500 acid

RECORD

Cased _____ in., _____ ft.

Sand _____

Gas _____

Oil _____

Total Depth _____

PRODUCTION

1st 24 hrs. Nat. _____

1st 24 hrs. after shot _____

Gas _____ Cu. Ft.

Dry Hole _____

Abandoned _____

Date

MAY 24 1950

19

J. E. TYRA Scout

swab 2 1/2 bot + 10 high

set plug 3175

Perf. J 3154-60

3111-1

3054-60

3050-050

3036-470

3016-20

2972-77

2762-67

Misc.
Pierce Map
France Map
Tracings
Land Wall Map
Land Small Map
Scout Cards

Alps
Dodge
Dippen

T.D. 3578

Comp [Signature]

Converted from #4
#5 in correct.

Sam

Check and advise

Your first report shows No. 4

not report about #4