

Map No. 51 Sec. 1 Twp. 14 R. 2W

Well No. 1 Stauffer

H. Meyer et al. Company

FIRST REPORT Contractor

C N L NE NE

SECTION PLAT

330 Ft. from N. Line

 Ft. from S. Line

660 Ft. from E. Line

 Ft. from W. Line

			6

Saline County

Location	RECORD
Rig up	Cased _____ in., _____ ft.
Drilling and Remarks: 20" @ 50' 15" @ 140' drlg. 165'	Sand _____
	Gas _____
	Oil _____
	Total Depth _____
	PRODUCTION
	1st 24 hrs. Nat. _____
	1st 24 hrs. after shot _____
	Gas _____ Cu. Ft.
	Dry Hole _____
	Abandoned _____

Date

OCT 16 1946 19 S. J. LEWIS Scout

Map No. 51 Sec. 1 Twp. 14 R. 2W

Well No. 1 Stauffer

H. Meyer et al. Company

ABANDONED Contractor

C N L NE NE

E11193
SECTION PLAT

330 Ft. from N. Line

 Ft. from S. Line

660 Ft. from E. Line

 Ft. from W. Line

			0

Saline County

Location	RECORD
Rig up	Cased _____ in., _____ ft.
Drilling and Remarks: <i>Cor 28235</i> <i>HFW</i>	Sand _____
	Gas _____
	Oil _____
	Total Depth <u>2408</u>
	PRODUCTION
	1st 24 hrs. Nat. _____
	1st 24 hrs. after shot _____
	Gas _____ Cu. Ft.
	Dry Hole _____
	Abandoned _____

Date

JUL 2 1947 19 S. J. LEWIS Scout

Sec. 1 Twp. 14 R. 2W

Well No. #1 Stauffer Farm

H. Meyer etal Company


Wildcat

330 Ft. from N. Line

Ft. from S. Line

660 Ft. from E. Line

Ft. from W. Line

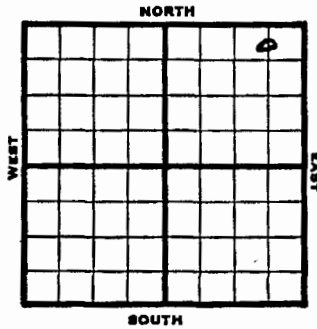

C N L NE NE

1946	Elev. 1193'	REPORT
10/16	20" @ 50'	
	15" @ 140'	
	Drlg 165'	
10/22	Drlg 660'	
10/29	Drlg 1085'	
11/6	" "	
11/12	" "	
11/20	Drlg 1200'	
11/27	Drlg 1750'	
12/3	SD	
12/10	12" @ 1200'	Pipe Collapsed
12/17	" "	
1947		
1/4	12" @ 1200'	Pipe collapsed
1/8	" "	" "
1/15	" "	" "
1/21	" "	" "
1/30	" "	" "

OVER

- 2/5 12" @ 1120
10" @ 1460'
Drlg 2020'
- 2/12 Lans 1935-2125
Run 8"
- 2/19 2440 OR 8"
- 2/26 8" @ 2290'
CO
- 3/4 8" @ 2315'
Drlg 2555'
- 3/11 Miss 2580'
Drlg 2600'
- 3/18 2240' UR 8"
- 3/25 SD
- 4/2 SD
- 4/9 "
- m4/15 "
- 4/25 "
- 4/29 Drlg 2800'
- 5/7 Drlg 2970'
- 5/13 Hunton 2980'
6" @ 2970'
Drlg. 3070'
- 5/20 " "
- 5/27 Viola 3180'-82' TD
6" @ 3180'
RUST
- 6/3 " " "
- 6/17 " " "
- 6/24 " " "

7/2 Arb. 3235'
HFW
TD 3408'

KANSAS
FORM 51 5M 6-46 PETROL

Saline county

Section 1 Township 14 Range 2-W

Well No. #1, Stauffer

Company H. Meyer etal

ABANDONED

