

Sec. 2 Twp. 14 R. 2 W

Well No. # 1 Hoeffner Farm

Atlantic Refg. Company

Honaker Contractor


Wildcat

Ft. from N. Line

330 Ft. from S. Line

Ft. from E. Line

330 Ft. from W. Line

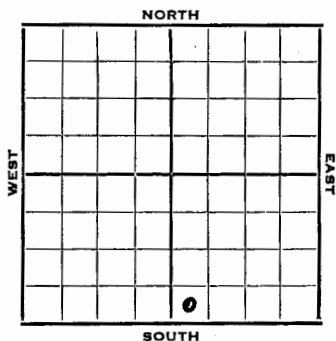

SW SW SE
CSO & Texas - support

1952 Elev. 1190' REPORT

7/2 Spud 7-1-52
7/9 8" @ 153 Heeb. 1689 Tor 1709
Lans. 1902
DST 1904-17 1 hr. 35' M 885#
KC 2052 Drlg. 2143

7/17 Miss 2527
DST 2627-45 1 hr. 750' SW 920#
KH 2773
DST 2756-73 1 hr. 1800' SW
Meisner 2897 Htn 2899
Lost Circu 2964

7/23 Mq. Dol 3139'

7/30 Spud 7-1-52
D & A TD 3387'
8" @ 153 Heeb 1689' Tor. 1709'
Lans. 1902'
DST 1904-17 open 1 hr. rec 35' mud
885#
KC 2052' Miss 2527'
DST 2627-45 open 1 hr. rec 750' SW
920# Kh. 2773'
DST 2756-73 open 1 hr. rec 1800' SW O#
Misener 2897' Hunton 2899' Maq. 3135
Viola 3163' Simp. 3239' Arb. 3330'
TD 3387' D & A

ABANDONED

Section 2 Township 14 Range 2W

Well No. #1 Hoeffner

Company Atlantic Refg.

