

Saline

KANSAS

SEC. 5	TWP. 14	R. 2W
-----------	------------	----------

WELL NO. #1 Winslow FARM

COMPANY DeWeese & T.W. Sanderson

CONTRACTOR Shields.

Saline Pool

Ft. from N. Line

330


Ft. from S. Line

990

Ft. from E. Line

Ft. from W. Line

SW SE SW

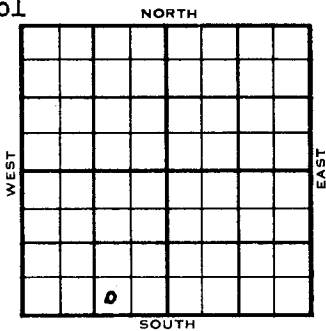

Saline


KANSAS

FORM 51

Section 5 Township 14 Range 2W

Well No. #1 Winslow

Company DeWeese & T.W. Sanderson

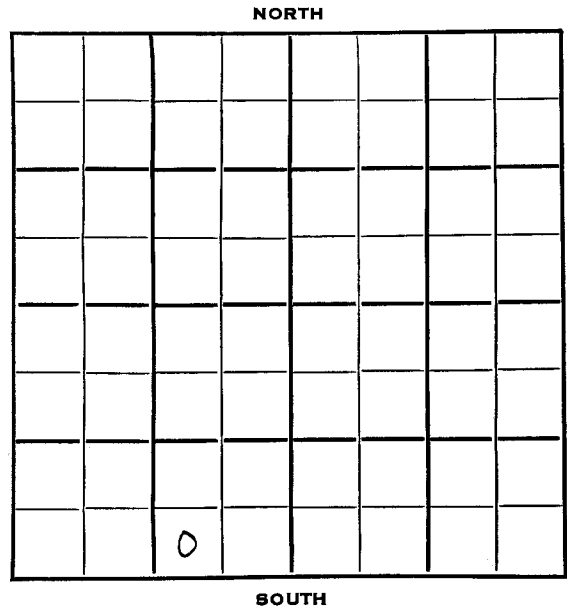

	ELEVATION	REPORT
1953	1211'	
11/11	Location	
11/18	8" @ 297'	Drlg. 1555'
11/24	Spud 11-11-53	
	D & A	
	TD 3200'	
	8" @ 297'	
	Miss 2292, Kh. 2817', Hunton 2969,	
	Sh 3092, Dol 3175'	
	SO 3175-86	
	TD 3200'	
	D & A	ABANDONED