

Kansas

County Saline State Kansas
 Sec. 6 (Bk. 14 (Sur. 2W Map No. 2W)
 Operator V. D. Sidey
 Well No. 1 Farm Corwin
 Elev. _____ Location NE NE SE

Map No. _____ Sec. 6 Twp. 14 R. 2W
 Well No. 1 Corwin
V. D. Sidey Company
CORRECTION Contractor

330 Ft. From N Line SE
330 Ft. From E Line Quarter
 1st. Report JAN 9 1952
 Completion _____
 Remarks Correction
 Spudding Date 1-5-52

SW NE SE
 _____ Ft. from N. Line
1850 Ft. from S. Line
990 Ft. from E. Line
 _____ Ft. from W. Line

SECTION PLAT

Drlg. Data Salina
10" @ 154 Drlg. 875

Saline County

Location _____
 Rig up _____
 Drilling and Remarks:
 Reported
NE NE SE

RECORD	
Cased _____ in., _____ ft.	
Sand _____	
Gas _____	
Oil _____	
Total Depth _____	
PRODUCTION	
1st 24 hrs. Nat. _____	
1st 24 hrs. after shot _____	
Gas _____ Cu. Ft.	
Dry Hole _____	
Abandoned _____	


Date JAN 9 1952
J. E. TYRA Scout

J. E. TYRA

Saline KANSAS


County Saline State Kansas
 Sec. 6 (Bk. 14) (Twp.) (Sur. 2W) (Rge.) Map No.
 Operator V. D. Sidey
 Well No. 1 Farm Corwin
 Elev. 1217 Location SW NE SE

Sec. 6 Twp. 14 R. 2 W
 Well No. # 1 Corwin Farm
V. D. Sidey Company
 Contractor

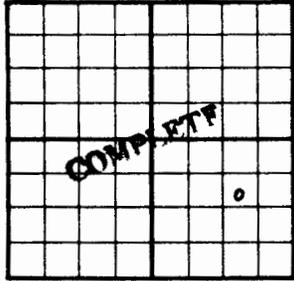

1850 Ft. From S Line SE
990 Ft. From E Line Quarter
 Ist. Report
 Completion MAR 19 1952
 Remarks Salina Pool
 Spudding Date 1-5-52

Salina
~~330~~ Ft. from N. Line
1850 Ft. from S. Line
~~990~~
~~330~~ Ft. from E. Line
 Ft. from W. Line

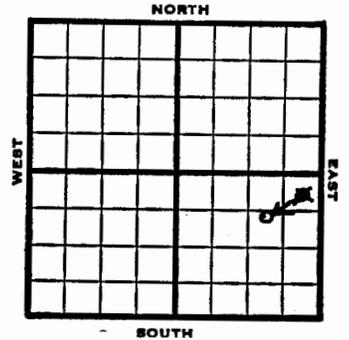

Drilg. Data Oil well TD 3194
10" @ 154 Maq. 3190 5" @ 3191
 TD 3194 P/ 5 to 6 bopd lot of sw
 Comp. 6 bopd

~~NE NE SE~~
~~SW NE SE~~

J. G. McGEHEE

1952	Elev. 1217'	REPORT
1/9		Spud 1-5-52 10" @ 154' Drilg. 875'
2/6		D.P.
2/13		No report
2/20		"
3/5		No report
3/12		"
3/19		Spud 1-5-52 Oil Well TD 3194 10" @ 154 Maq. 3190 5" @ 3191 TD 3194 P/ 5 to 6 bopd lot of sw Comp. 6 bopd

COMPLETED

Section 6 Township 14 Range 2W

Well No. #1 Corwin

Company V. D. Sidey

