


Saline KANSAS

County Saline State Kansas
 Sec. 6 (Blk. Twp.) 14 (Sur. Rge.) 2W Map No.
 Operator Bud Corum & Harold Crosswy
 Well No. 1 Farm Corum
 Elev. 1211 Location SE NE SE

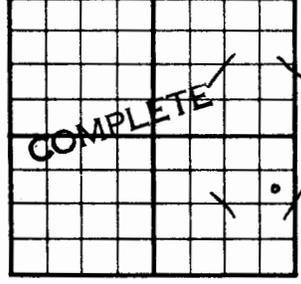

990 Ft. From N Line SE
330 Ft. From E Line Quarter
 Ist. Report
 Completion JUL 21 1954
 Remarks Salina Pool
Stearns Drlg. - Contr.
 Spudding Date 6-2-54


Drlg. Data Oil well TD 3179
8" @ 153 Lans. 1962 Miss. 2612
Viola 3174 TD 3179 5" @ 3174
CO to 3179 frac Comp. 50 bopd 50 bw

J. G. McGEHEE

SEC. 6 TWP. 14 R. 2W
 WELL NO. #1 Corum FARM
 COMPANY
Bud Corum & Harold Crosswy
 CONTRACTOR

Stearns Drlg.

990
~~330~~ Ft. from N. Line
 Ft. from S. Line
330 Ft. from E. Line
 Ft. from W. Line

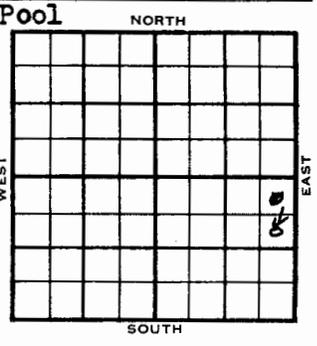

SE
NE NE SE

1954 ELEVATION 1211 REPORT

5/26 Location
6/2 "
6/9 8" @ 153 w/125 SD 1972' repairs
7/21 Spdg 6-2-54
Oil well
TD 3179
8" @ 153
Lans. 1962 Miss. 2612 Viola 3174
TD 3179
5" @ 3174
CO to 3179 frac comp. 50 bopd
50 bw

COMPLETED

DX 78-1

Saline Kansas

Section 6 Township 14 Range 2W
Well No. 1 Corum
Company Bud Corum & Harold Crosswy

