

County **Saline** State **Kansas**

Sec. **7** (Blk. Twp.) **14** (Sur. Rge.) **2W** Map No.

Operator **V. D. Sidey**

Well No. **1** Farm **Dillingham**

Elev. Location **N/2 SE NE**

990 Ft. From **S** Line **NE**

660 Ft. From **E** Line Quarter

1st. Report **JAN 16 1952**

Completion

Remarks **Sidey - Contr.**

Spudding Date

Drig. Data **Salina**

Location

FIRST REPORT

J. E. TYRA

County **Saline** State **Kansas**

Sec. **7** (Blk. Twp.) **14** (Sur. Rge.) **2W** Map No.

Operator **V. D. Sidey**

Well No. **1** Farm **Dillingham**

Elev. **1212** Location **C N L SE NE**

990 Ft. From **S** Line **NE**

660 Ft. From **E** Line Quarter

1st. Report

Completion **MAR 16 1952**

Remarks **Salina Pool**

Sidey - Contr.

Spudding Date **1-28-52**

Drig. Data

8" @ 154 Maq. 3156 Viola 3161

5" @ 3157 TD 3159 Comp. 15 to 30 bopd

COMPLETE

J. G. McGEHEE

Saline

KANSAS

Sec. 7 Twp. 14 R. 2W ✓

Well No. #1 Dillingham Farm

V. D. Sidey Company


Sidey Contractor
Salina

990 Ft. from N. Line

660 Ft. from S. Line

660 Ft. from E. Line

N/2 SE NE Ft. from W. Line

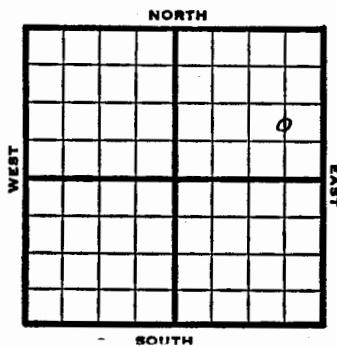

1952 Elev. 1212' REPORT

1/16 Location
2/6 Drlg. 2523'
8" @ 154'
2/13 No Report
2/20 "
3/5 "
3/12 Viola 3161'
P/30 BOPD
3/19 Spud 1-28-52
8" @ 154'
Maq. 3156 Viola 3161
5" @ 3157' TD 3159
Comp. 15 to 30 bopd

COMPLETED

KANSAS

Section 7 Township 14 Range 2W

Well No. #1 Dillingham

Company V. D. Sidey

