

Map No. _____ Sec. 7 Twp. 14 R. 2WWell No. 2 Putman

S. M. Griscom _____ Company

FIRST REPORT

Contractor

NE SW


SECTION PLAT

330 Ft. from N. Line

_____ Ft. from S. Line

330 Ft. from E. Line

_____ Ft. from W. Line

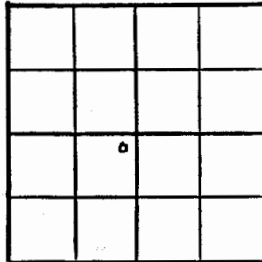

Saline County

Location _____

RECORD

Cased _____ in., _____ ft.

Sand _____

Gas _____

Oil _____

Total Depth _____

PRODUCTION

1st 24 hrs. Nat. _____

1st 24 hrs. after shot _____

Gas _____ Cu. Ft.

Dry Hole _____

Abandoned _____

Date

JUN 1 1 1947 19 S. J. LEWIS Scout

Map No. 51 Sec. 7 Twp. 14 R. 2WWell No. 2 Putman

S. M. Griscom _____ Company

COMPLETE

Contractor

NE SW


SECTION PLAT

330 Ft. from N. Line

_____ Ft. from S. Line

330 Ft. from E. Line

_____ Ft. from W. Line

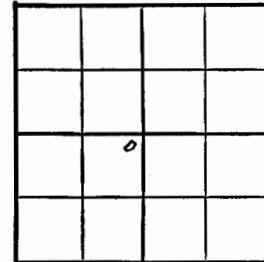

Saline County

Location _____

RECORD

Cased _____ in., _____ ft.

Sand _____

Gas _____

Oil _____

Total Depth 8191

PRODUCTION

1st 24 hrs. Nat. _____

1st 24 hrs. after shot _____

Gas _____ Cu. Ft.

Dry Hole _____

Abandoned _____

Date

JUL 2 1947 19 S. J. LEWIS Scout

Saline

Sec. 7 Twp. 14 R. 2-W

Well No. #2 Putman Farm


S. M. Griscom Company

330 Ft. from N. Line

_____ Ft. from S. Line

330 Ft. from E. Line

_____ Ft. from W. Line

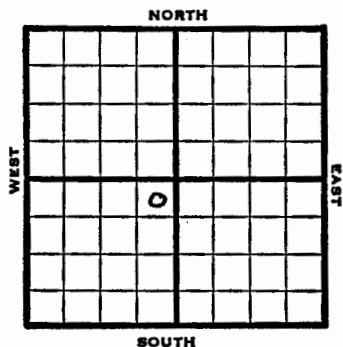

NE SW

REPORT

1947

6/11 8" @ 152'
Drlg 255'

6/17 Mississippi 2660'
Drlg 2665'

6/24 " " "

7/2 Viola 3189'
5" @ 3189'
Pump 50 Oil / 14W pot
36.0 Gr.
TD 3191'

COMPLETED

Saline

KANSAS

Section 7 Township 14 Range 2-W

Well No. #2 Putman

Company S. M. Griscom
Saline

