FORM 275 FOR SALE BY KANSAS BLUE PRINT CO.

County Saline State [illegible]

Sec. 9 (Blk. Twp.) 14 (Sur. Rge.) 2W Map No.

Operator Anschutz Drlg.

Well No. 1 Farm Raisner

Elev. Location NE NE SW



330 Ft. From N Line SW

330 Ft. From E Line Quarter

1st. Report NOV 28 1951

Completion

Remarks Penguin Drlg. - Contr.

Spudding Date

Drlg. Data Wildcat

Location

J. E. TYRA

FORM 275 FOR SALE BY KANSAS BLUE PRINT CO.


County Saline State Kansas

Sec. 9 (Blk. Twp.) 14 (Sur. Rge.) 2W Map No.

Operator Anschutz Drlg.

Well No. 1 Farm Raisner

Elev. 1225 Location NE NE SW

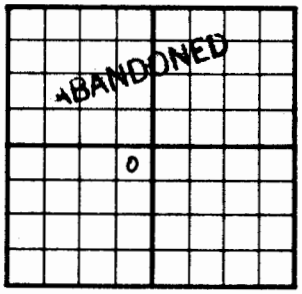

330 Ft. From N Line SW

330 Ft. From E Line Quarter

1st. Report

Completion DEC 19 1951

Remarks Wildcat

Penguin Drlg. - Contr

Spudding Date 11-29-51

Drlg. Data D & A TD 3370

8" @ 165 Miss. 2595 Kh. 2830

Misener 2955 Hunton 2957

DST 2955-73 open ½ hr. Rec. 6' mud DST 3165-70 open ½ hr. Rec. 7' mud Viola 3191 DST 3285-87 open ½ hr. Rec. 15' mud & water Simp. 3331 Arb. 3362-70 TD D & A

J. E. TYRA

FORM 252-B
10M 8-51 TPCO.

Saline KANSAS

Sec. 9 Twp. 14 R. 2W

Well No. #1 Raisner Farm

Anschutz Drlg. Company

Penguin Drlg. -Contr. Contractor

Wildcat


330' Ft. from N. Line

Ft. from S. Line

330' Ft. from E. Line

Ft. from W. Line

NE NE SW

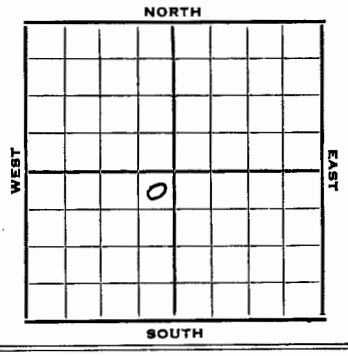

1951	Elev. 1225'	REPORT
11/28	Location	
12/18	Spud 11-29-51 D&A TD 3370 8" @ 165 Miss. 2595 Kh. 2830 Misener 2955 Hunton 2957 DST 2955-73 open ½ hr. rec. 6' mud DST 3165-70 open ½ hr. Rec. 7' mud Viola 3191 DST 3285-87 open ½ hr. rec. 15' mud & wtr. Simp. 3331' Arb. 3362-70 TD D&A ABANDONED	

FORM 51 25M 8-50 WESTERN Saline KANSAS

Section 9 Township 14 Range 2W

Well No. #1 Raisner

Company Anschutz Drlg.

