FORM 26 200 BKS. 2-44 PETROL

KANSAS 51

Kansas Pool Name Salina

Map No. 51 Sec. 17 Twp. 14 R. 2W


Well No. 2 Sietz

Westgate-Greenland Company

FIRST REPORT Contractor

SW SE NW

SECTION PLAT

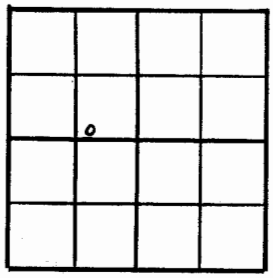

____ Ft. from N. Line

330 Ft. from S. Line

990 Ft. from E. Line

____ Ft. from W. Line

Saline County

Location ✓

Rig up

Drilling and Remarks:

RECORD

Cased ____ in., ____ ft.

Sand

Gas

Oil

Total Depth

PRODUCTION

1st 24 hrs. Nat.

1st 24 hrs. after shot

Gas Cu. Ft.

Dry Hole

Abandoned

Date

MAY 15 1946 19 S. J. LEWIS Scout

FORM KANSAS 2-44 PETROL

Kansas Pool Name Salina Pool

Map No. 51 Sec. 17 Twp. 14 R. 2W

Well No. 2 Sietz


Westgate-Greenland Company

COMPLETED Contractor

SW SE NW

E 1/2 NW 1/4

SECTION PLAT

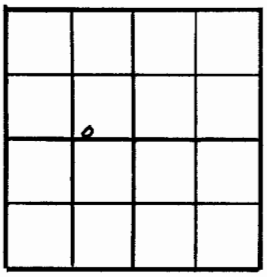

____ Ft. from N. Line

330 Ft. from S. Line

990 Ft. from E. Line

____ Ft. from W. Line

Saline County

Location

Rig up

Drilling and Remarks:

Viola 3236

5" C 3236

1000 acid

Pump 453 Bbl

36 hr Pot

RECORD

Cased ____ in., ____ ft.

Sand

Gas

Oil

Total Depth 3251

PRODUCTION

1st 24 hrs. Nat.

1st 24 hrs. after shot

Gas Cu. Ft.

Dry Hole

Abandoned

Date

JUN 5 1946 19 S. J. LEWIS Scout

FORM 252-A
5M 12-45 PETROL

KANSAS Saline County

Sec. 17 Twp. 14 R. 2W

Well No. #2 Sietz Farm

Westgate Greenland Company

Salina


____ Ft. from N. Line

330 Ft. from S. Line

990 Ft. from E. Line

____ Ft. from W. Line

SW SE NW

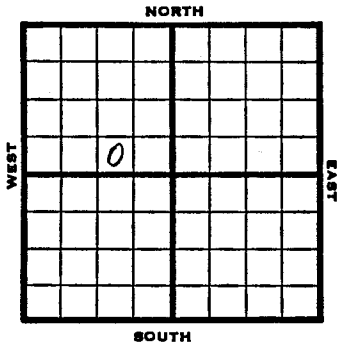

REPORT

1946	Elev.1261
5/15	Location
5/21	8" @ 150 Drlg 1870'
5/29	Viola 3236 TD 3241 5" @ 3236 RUST
6/5	Viola 3236 5" @ 3236 1000 acid. TD 3251' Pump 453 Pot. Grav. 36.0

COMPLETED

FORM 51 5M 11-44 PETROL

KANSAS /Salina

Section 17 Township 14 Range 2W

Well No. 2 Sietz

Company Westgate-Greenland

