

Kansas Pool Name Salina

Map No. 51 Sec. 17 Twp. 14 R. 2W


Well No. 1 Prescott

Westgate-Greenland Company

FIRST REPORT Contractor

NW SE SW

SECTION PLAT

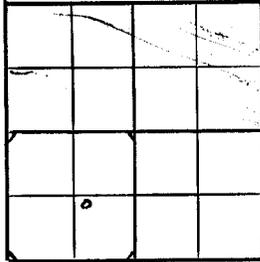

_____ Ft. from N. Line

990 Ft. from S. Line

990 Ft. from E. Line

_____ Ft. from W. Line

Salina

Location _____

Rig up _____

Drilling and Remarks:

10"-200
475

RECORD

Cased _____ in., _____ ft.

Sand _____

Gas _____

Oil _____

Total Depth _____

PRODUCTION

1st 24 hrs. Nat. _____

1st 24 hrs. after shot _____

Gas _____ Cu. Ft.

Dry Hole _____

Abandoned _____

Date

APR 18 1945 19

S. J. LEWIS Scout

Kansas Pool Name Salina

Map No. 51 Sec. 17 Twp. 14 R. 2W


Well No. 1 Prescott

Westgate-Greenland Company

COMPLETED Contractor

NW SE SW

SECTION PLAT

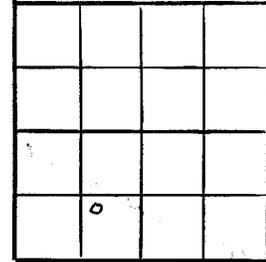

_____ Ft. from N. Line

990 Ft. from S. Line

990 Ft. from E. Line

_____ Ft. from W. Line

Salina County

Location _____

Rig up _____

Drilling and Remarks:

Nota 3288
Cr 48443
7" @ 3302
6726 to 68235-53
10000 Cu. Ft.
Pump 245 gal + 29
124

RECORD

Cased _____ in., _____ ft.

Sand _____

Gas _____

Oil _____

Total Depth 3474

PRODUCTION

1st 24 hrs. Nat. _____

1st 24 hrs. after shot _____

Gas _____ Cu. Ft.

Dry Hole _____

Abandoned _____

Date

MAY 16 1945 19

S. J. LEWIS Scout

Salina

Sec. 17 Twp. 14 S R. 2 W

Well No. #1 Prescott Farm

WESTGATE-GREENLAND Company


Salina

_____ Ft. from N. Line

990' Ft. from S. Line

990' Ft. from E. Line

_____ Ft. from W. Line

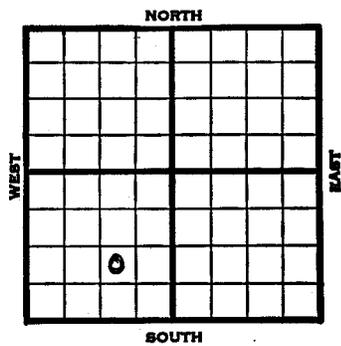

NW SE SW

1945 1267 REPORT
~~Elev. 3286~~

4-18 10" at 200'
Drilling 475'

4/27 Drlg. 3000'
5/3 No report

5/16 Viola 3288
Arb 3443

7" @ 3302
TD 3484
68 shots 3238-3253
1000 acid.
Pump 245 oil plus 2% wtr. Pot.
Grav. 36.0

COMPLETED

Section 17 Township 14 Range 2W

Well No. 1 Prescott

Company Westgate-Greenland

