

Map No. 51 Sec. 18 Twp. 14 R. 2W

Well No. 1 Duncan etal.

Currier & Keyes Drlg. Company

FIRST REPORT Contractor

C W L NW NE

SECTION PLAT

		a	

660 Ft. from N. Line

_____ Ft. from S. Line

_____ Ft. from E. Line

330 Ft. from W. Line

Saline County

Location _____

Rig up _____

Drilling and Remarks:

8" @ 173
drlg. 2642

RECORD

Cased _____ in., _____ ft.

Sand _____

Gas _____

Oil _____

Total Depth _____

PRODUCTION

1st 24 hrs. Nat. _____

1st 24 hrs. after shot _____

Gas _____ Cu. Ft.

Dry Hole _____

Abandoned _____

Date

JAN 22 1947 19 S. J. LEWIS Scout

Map No. 51 Sec. 18 Twp. 14 R. 2W

Well No. 1 Duncan etal.

Currier & Keyes Drlg. Company

CORRECTION Contractor

C W L SW NW NE)

SECTION PLAT

890 Ft. from N. Line

_____ Ft. from S. Line

_____ Ft. from E. Line

50 Ft. from W. Line

Saline County

Location _____

Rig up _____

Drilling and Remarks:

Reported
C W L NW NE

RECORD

Cased _____ in., _____ ft.

Sand _____

Gas _____

Oil _____

Total Depth _____

PRODUCTION

1st 24 hrs. Nat. _____

1st 24 hrs. after shot _____

Gas _____ Cu. Ft.

Dry Hole _____

Abandoned _____

Date

JAN 20 1947 19 S. J. LEWIS Scout

Map No. 51 Sec. 18 Twp. 14 R. 2W

Sec. 18 Twp. 14 R. 2-W

Well No. 1 Duncan etal.

Well No. #1, Duncan etal Farm

Currier & Keyes Drlg. Company

Currier and Keyes Drilling. Company

COMPLETE

Salina Pool


Contractor

890
660* Ft. from N. Line

C W L SW NW NE

E1,123
SECTION PLAT

890 Ft. from N. Line

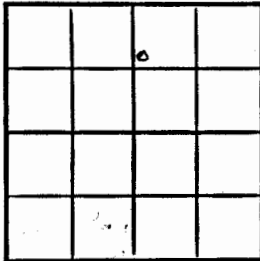

Ft. from S. Line


Ft. from S. Line

Ft. from E. Line

Ft. from E. Line

50 Ft. from W. Line

50
350* Ft. from W. Line

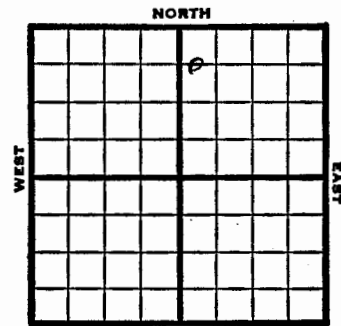

C WL NW NE SW NW NE

Saline County

REPORT

Location

RECORD

Rig up

Cased _____ in. _____ ft.

Drilling and Remarks:

Sand _____

Viola 3189

Gas _____

5' @ 3191

Oil _____

1500 Acid

Total Depth 3192

Pump 710 Pot

PRODUCTION

1st 24 hrs. Nat. _____

1st 24 hrs. after shot _____

Gas _____ Cu. Ft.

Dry Hole _____

Abandoned _____

1947

Elev. 1231

Date

FEB 19 1947 19

S. J. LEWIS

Scout

1/22

8" @ 173'
Drlg. 2642'

1/30

Miss 2663
Hunton 2892
Viola 3189
TD 3191
5" @ 3191
RUST

2/5

TD 3192
1700' oil 12 hrs
1500 Acid

2/12

" "

2/19

Viola 3189
5" @ 3191
1500 Acid
Pump 710 Pot
Grav. 36
TD 3192'

COMPLETED

KANSAS

Saline county

Section 18 Township 14 Range 2-W

Well No. #1, Duncan etal

Company Currier and Keyes Drilg.

