

KANSAS

Pool Name Salina

Map No. 5 / Sec. 18 Twp. 14 R. 2W


Well No. 1 White-Duncan

Boller & Keyes etal. Company

FIRST REPORT Contractor

NE SW NE

SECTION PLAT

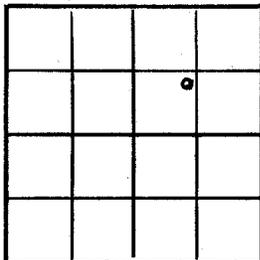

Ft. from N. Line

990 Ft. from S. Line

Ft. from E. Line

990 Ft. from W. Line

Saline County

Location X

Rig up

Drilling and Remarks:

RECORD

Cased          in,          ft.

Sand         

Gas         

Oil         

Total Depth         

PRODUCTION

1st 24 hrs. Nat.         

1st 24 hrs. after shot         

Gas          Cu. Ft.

Dry Hole         

Abandoned         

Date

JUL 10 1946 19

S. J. LEWIS Scout

KANSAS

Pool Name Salina

Map No. 5 / Sec. 18 Twp. 14 R. 2W


Well No. 1 White-Duncan

Boller & Keyes etal. Company

CORRECTION Contractor

NE SW NE

SECTION PLAT

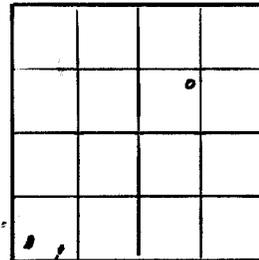

Ft. from N. Line

1280 Ft. from S. Line

Ft. from E. Line

900 Ft. from W. Line

Saline County

Location X

Rig up

Drilling and Remarks:

Reported

990 x 990

RECORD

Cased          in,          ft.

Sand         

Gas         

Oil         

Total Depth         

PRODUCTION

1st 24 hrs. Nat.         

1st 24 hrs. after shot         

Gas          Cu. Ft.

Dry Hole         

Abandoned         

Date

JUL 31 1946 19

S. J. LEWIS Scout

**KANSAS** Kansas Pool Name Salina Pool

**KANSAS** Saline County ✓

Map No. 57 Sec. 18 Twp. 14 R. 2W

Sec. 18 Twp. 14 R. 2W

Well No. 1 White-Duncan

Well No. #1 White-Duncan Farm

Boller & Keyes et al. Company  
**COMPLETED**

Boller & Keyes et al Company

Salina

NE SW NE

Contractor


E11262  
SECTION PLAT

         Ft. from N. Line

1280 Ft. from S. Line

         Ft. from E. Line

900 Ft. from W. Line

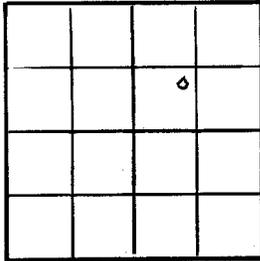


         Ft. from N. Line

1280  
990 Ft. from S. Line

         Ft. from E. Line

900  
990 Ft. from W. Line

NE SW NE

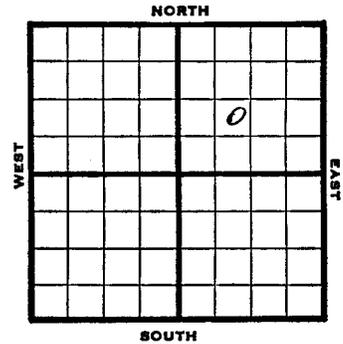

Salina Pool

1946 Elev. 1262 REPORT

Location

Rig up

Drilling and Remarks:

*Viola 3220*  
*5" @ 3220*  
*1000 acid*  
*Pump 612 oil*  
*10% W. Pot*

**RECORD**

Cased          in,          ft.

Sand         

Gas         

Oil         

Total Depth 3222

**PRODUCTION**

1st 24 hrs. Nat.         

1st 24 hrs. after shot         

Gas          Cu. Ft.

Dry Hole         

Abandoned         

Date

JUL 31 1946 19 S. J. LEWIS Scout

7/10

Location

7/16

8" @ 196  
Drlg 1670'

7/23

Miss 2710  
Hunton 3030  
Drlg 3196'

7/31

Viola 3220  
5" @ 3220  
TD 3222'  
1000 acid.  
Pump 612 oil plus 10% W. Pot.  
Grav. 39.0

**COMPLETED**

KANSAS

FORM 51 5M 6-48 PETROL

Saline County

Section 18 Township 14 Range 2W

Well No. #1 White-Duncan

Company Boller & Keyes et al

