

Pool Name SalinaMap No. 51 Sec. 18 Twp. 14 R. 2WWell No. 1 Loux

Globe Oil Ref.

Company

FIRST REPORT

Contractor

NE SE


SECTION PLAT

330 Ft. from N. Line

Ft. from S. Line

330 Ft. from E. Line

Ft. from W. Line

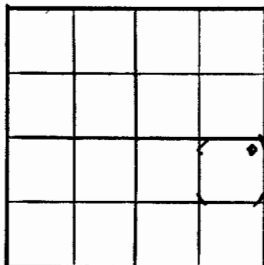

Saline

Location

RECORD

Cased in, ft.

Sand

Gas

Oil

Total Depth

PRODUCTION

1st 24 hrs. Nat.

1st 24 hrs. after shot

Gas Cu. Ft.

Dry Hole

Abandoned

Date

SEP 19 1945 19

S. J. LEWIS Scout

KANSAS

Pool Name SalinaMap No. 51 Sec. 18 Twp. 14 R. 2WWell No. 1 Loux

Globe Oil Ref.

Company

COMPLETED

Contractor

NE SE


SECTION PLAT

330 Ft. from N. Line

Ft. from S. Line

330 Ft. from E. Line

Ft. from W. Line

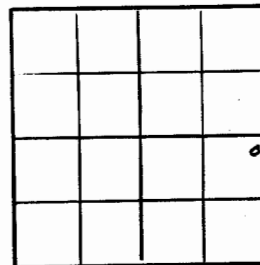

Saline County

Location

RECORD

Cased in, ft.

Sand

Gas

Oil

Total Depth 3257

PRODUCTION

1st 24 hrs. Nat.

1st 24 hrs. after shot

Gas Cu. Ft.

Dry Hole

Abandoned

Date

OCT 24 1945 19

S. J. LEWIS Scout

KANSAS Saline

Sec. 18 Twp. 14 R. 2-W

Well No. #1 Loux Farm


Globe Oil Ref. Company

330 Ft. from N. Line

_____ Ft. from S. Line

330 Ft. from E. Line

_____ Ft. from W. Line

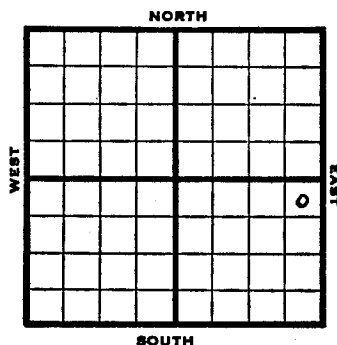

NE SE

1945 Elev. 1276 REPORT

9/19 RUR

10/3 Drlg. 2750
10/10 Viola 3253-3257

TD 3257 SO
5" @ 3253 RUST

10/17 400' oil in 12 hrs.

10/24 Viola 3253

5" @ 3253

500 acid.

TD 3257'

Pump 519 oil plus 2% wtr. Pot.

Grav. 36.0

COMPLETED

KANSAS

Saline

Section 18 Township 14 Range 2W

Well No. 1 Loux

Company Globe Oil Ref.

