

County **Saline** State **Kansas**
 Sec. **19** (Blk. Twp.) **14** (Sur. Rge.) **2W** Map No.
 Operator **Caddo Oil etal.**
 Well No. **1** Farm **Becker**
 Elev. Location **SW NE NW**
 1090 Ft. From **N** Line **NW**
 750 Ft. From **E** Line Quarter
 1st. Report **JAN 2 1952**
 Completion
 Remarks
Honaker Drlg. - Contr.
 Spudding Date **12-20-51**

Drlg. Data **Saline Pool****8" @ 136 KC 1997 Miss. 2640****Kh. 2895 Hunton 3014 drlg. 3085**

J. E. TYRA

County **Saline** State **Kansas**
 Sec. **19** (Blk. Twp.) **14** (Sur. Rge.) **2W** Map No.
 Operator **Caddo Oil etal.**
 Well No. **1** Farm **Becker**
 Elev. **1223** Location **C S L NE NW**
 1090 Ft. From **N** Line **NW**
 750 Ft. From **E** Line Quarter
 1st. Report
 Completion **JAN 2 1952**
 Remarks **Saline Pool**
Honaker Drlg. - Contr.
 Spudding Date **12-20-51**

Drlg. Data **D & A TD 3320****8" @ 136 KC 1997 Miss. 2640****Kh. 2895 Hunton 3037 Mag. 3223****TD 3320 D & A**

J. E. TYRA

KANSAS

Sec. **19** Twp. **14** R. **2W**

Well No. **#1 Becker** Farm

Caddo Oil et al Company

Honaker Drlg. Contractor

Saline Pool


1090 Ft. from N. Line

Ft. from S. Line

750 Ft. from E. Line

Ft. from W. Line


C SL NE NW

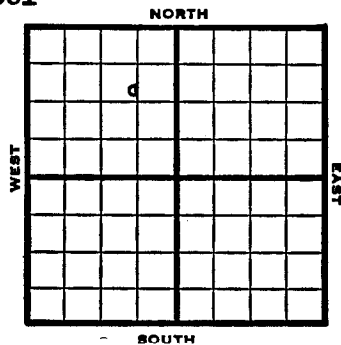

Section **19** Township **14** Range **2W**

Well No. **#1 Becker**

Company **Caddo Oil et al**

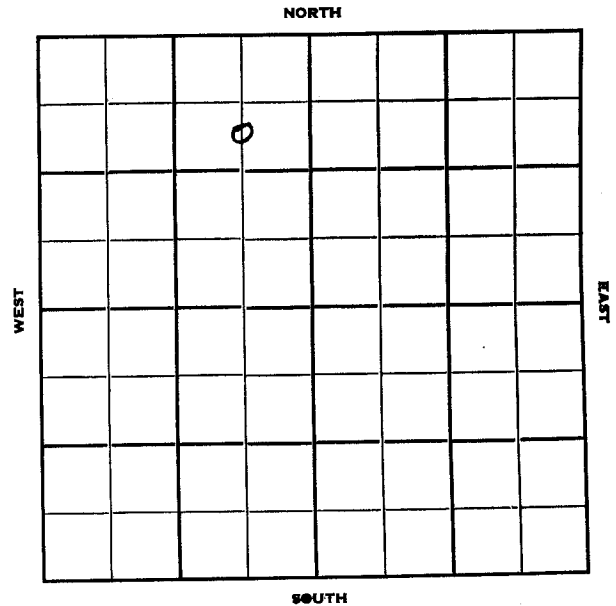

1952 **Elev. 1223'** **REPORT**

1/2 Spud 12-20-51
8" @ 136'
KC1997 Miss. 2640
Kh. 2895 Hunton 3014
Drlg. 3085'

1/9 Spud 12-20-51
D & A TD 3320' 8" @ 136'
KC 1997' Miss 2640' Kh. 2895'
Hunton 3037' Maq. 3223'
TD 3320' D & A

ABANDONED