

Saline

KANSAS

Sec. 19 Twp. 14 R. 2 W

Well No. # 1 Johnson Farm _____

Northwestern Drlg. Company _____

Contractor _____

Salina Pool


Ft. from N. Line _____

990 Ft. from S. Line _____

Ft. from E. Line _____

330 Ft. from W. Line _____

NW SW NW

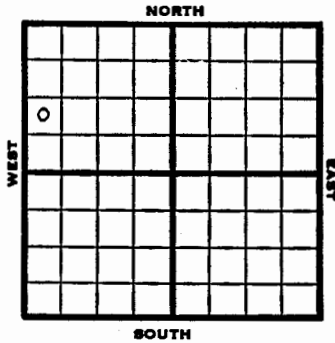


Saline KANSAS

Section 19 Township 14 Range 2W

Well No. 1 Johnson

Company Northwestern Drlg.

NORTH

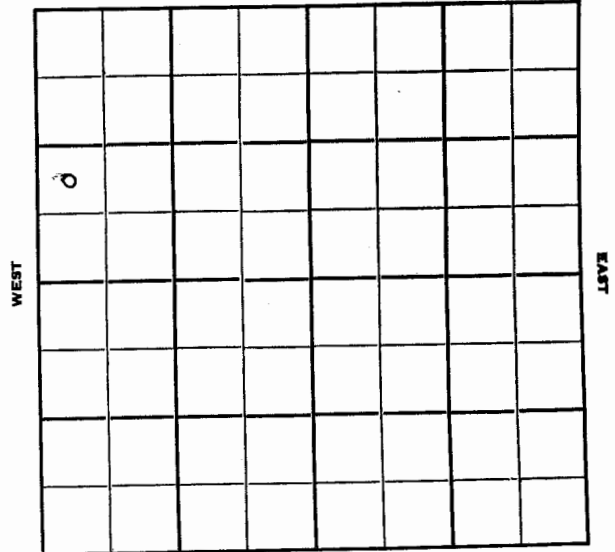

SOUTH

1951

Elev. 1226' REPORT

8/1

Spud 7-26-51
8" @ 137
Drlg. 840'

8/29

Spud 7-26-51
Oil Well TD 3209
8" @ 137
KC 2141 Miss 2628
Hunton 3040 Vi la 3202
TD 3204 5" @ 3202
DD 3209 FU 900' oil 100' wtr
12 hr. FU 210' oil 30' wtr
1 hr S/4 bo 1 bwph 6 hr.
Comp. 60 bopd bw
COMPLETED