

KANSAS

Pool Name Salina

Map No. \_\_\_\_\_ Sec. 20 Twp. 14 R. 2W

Well No. 1 Becker

Westgate Greenland Company

FIRST REPORT Contractor

NW SW SW

SECTION PLAT


\_\_\_\_\_ Ft. from N. Line

990 Ft. from S. Line

\_\_\_\_\_ Ft. from E. Line

330 Ft. from W. Line

Salina

Location \_\_\_\_\_

Rig up \_\_\_\_\_

Drilling and Remarks:

R U R

RECORD

Cased \_\_\_\_\_ in., \_\_\_\_\_ ft.

Sand \_\_\_\_\_

Gas \_\_\_\_\_

Oil \_\_\_\_\_

Total Depth \_\_\_\_\_

PRODUCTION

1st 24 hrs. Nat. \_\_\_\_\_

1st 24 hrs. after shot \_\_\_\_\_

Gas \_\_\_\_\_ Cu. Ft.

Dry Hole \_\_\_\_\_

Abandoned \_\_\_\_\_

Date

JAN 17 1945 19 S. J. LEWIS Scout

Pool Name Salina

Map No. K51 Sec. 20 Twp. 14 R. 2W

Well No. 1 Vgn Ness

Westgate-Greenland Company

CORRECTION Contractor

NW SW SW

SECTION PLAT


\_\_\_\_\_ Ft. from N. Line

990 Ft. from S. Line

\_\_\_\_\_ Ft. from E. Line

330 Ft. from W. Line

Salina

Location \_\_\_\_\_

Rig up \_\_\_\_\_

Drilling and Remarks:

name changed  
from #1 Beck

RECORD

Cased \_\_\_\_\_ in., \_\_\_\_\_ ft.

Sand \_\_\_\_\_

Gas \_\_\_\_\_

Oil \_\_\_\_\_

Total Depth \_\_\_\_\_

PRODUCTION

1st 24 hrs. Nat. \_\_\_\_\_

1st 24 hrs. after shot \_\_\_\_\_

Gas \_\_\_\_\_ Cu. Ft.

Dry Hole \_\_\_\_\_

Abandoned \_\_\_\_\_

Date

FEB 7 1945 19 S. J. LEWIS Scout

Pool Name Saline

Map No. 5 Sec. 20 Twp. 14 R. 2W

Well No. 1 Van Ness

Westgate Greenland Company

**COMPLETED** Contractor

NW SW SW


SECTION PLAT

\_\_\_\_\_ Ft. from N. Line

990 Ft. from S. Line

\_\_\_\_\_ Ft. from E. Line

330 Ft. from W. Line

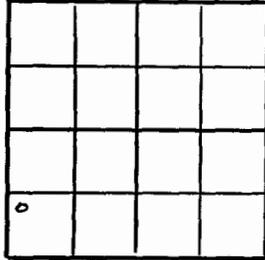

Saline

Location \_\_\_\_\_

Rig up \_\_\_\_\_

Drilling and Remarks:

*Vw 3243*  
*Simp 3443*  
*Arb 3452*  
*7" @ 3298*  
*67 shots 3243-55*  
*1000 acid*  
*Pump 284 oil + 15% wtr.*  
*W. J. Lewis*

RECORD

Cased \_\_\_\_\_ in., \_\_\_\_\_ ft.

Sand \_\_\_\_\_

Gas \_\_\_\_\_

Oil \_\_\_\_\_

Total Depth 3549

PRODUCTION

1st 24 hrs. Nat. \_\_\_\_\_

1st 24 hrs. after shot \_\_\_\_\_

Gas \_\_\_\_\_ Cu. Ft.

Dry Hole \_\_\_\_\_

Abandoned \_\_\_\_\_

Date 36<sup>th</sup>

FEB 21 1945 19 S. J. LEWIS Scout

KANSAS

Saline

Sec. 20 Twp. 14 R. 2W

Well No. #1 Becker Van Ness Farm

Westgate Greenland Company


Salina

\_\_\_\_\_ Ft. from N. Line

990 Ft. from S. Line

\_\_\_\_\_ Ft. from E. Line

330 Ft. from W. Line

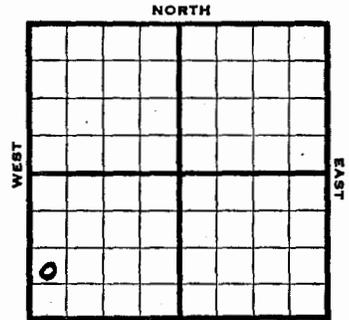

NW SW SW E 1268 SOUTH

1945

REPORT

1/17

RUR

1/26

"

1/31

10" @ 175'  
Drlg. 1425'

2/7

Drlg 2750

2/14

Lans 2018  
Miss 2691  
Hunton 3088  
Viola 3243  
Simp 3373  
Arb 3452

2/21

TD 3503 7" @ 3298 RUST  
Viola 3243  
Simp 3443  
Arb. 3452  
7" @ 3298  
67 shots 3243-3255  
1000 acid  
TD 3503  
Pump 284 oil plus 15% wtr.  
Pot.  
Grav. 36.0

**COMPLETED**

KANSAS Saline County

Section 20 Township 14 Range 2W

Well No. #1 Becker Van Ness

Company Westgate Greenland

