

Map No. \_\_\_\_\_ Sec. 20 Twp. 14 R. 2W

Well No. 1 Cravens


L. D. Jackson Drlg. Company

FIRST REPORT Contractor

NW SE SW

SECTION PLAT

\_\_\_\_\_ Ft. from N. Line  
990 Ft. from S. Line  
990 Ft. from E. Line  
\_\_\_\_\_ Ft. from W. Line

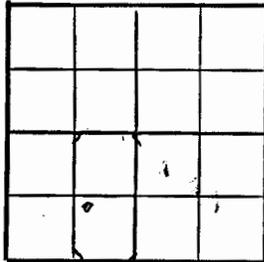

Saline County

Location \_\_\_\_\_

Rig up \_\_\_\_\_

Drilling and Remarks:

10" @ 240  
drlg. 1210

RECORD

Cased \_\_\_\_\_ in., \_\_\_\_\_ ft.  
Sand \_\_\_\_\_  
Gas \_\_\_\_\_  
Oil \_\_\_\_\_  
Total Depth \_\_\_\_\_

PRODUCTION

1st 24 hrs. Nat. \_\_\_\_\_  
1st 24 hrs. after shot \_\_\_\_\_  
Gas \_\_\_\_\_ Cu. Ft.  
Dry Hole \_\_\_\_\_  
Abandoned \_\_\_\_\_

Date

JUN 4 1947 19

S. J. LEWIS Scout

Map No. 51 Sec. 20 Twp. 14 R. 2W

Well No. 1 Cravens


L. D. Jackson Drlg. Company

ABANDONED Contractor

NW SE SW

SECTION PLAT

\_\_\_\_\_ Ft. from N. Line  
990 Ft. from S. Line  
990 Ft. from E. Line  
\_\_\_\_\_ Ft. from W. Line

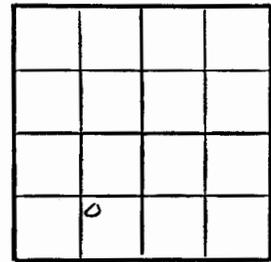

Saline County

Location \_\_\_\_\_

Rig up \_\_\_\_\_

Drilling and Remarks:

Water 8243  
Brine 3447

RECORD

Cased \_\_\_\_\_ in., \_\_\_\_\_ ft.  
Sand \_\_\_\_\_  
Gas \_\_\_\_\_  
Oil \_\_\_\_\_  
Total Depth 8452

PRODUCTION

1st 24 hrs. Nat. \_\_\_\_\_  
1st 24 hrs. after shot \_\_\_\_\_  
Gas \_\_\_\_\_ Cu. Ft.  
Dry Hole \_\_\_\_\_  
Abandoned \_\_\_\_\_

Date

JUL 2 3 1947 19


S. J. LEWIS Scout



Sec. 20 Twp. 14 R. 2W

Well No. 1 Carvens Farm  
L. D. Jackson Drlg. Company

\_\_\_\_\_ Ft. from N. Line  
990 Ft. from S. Line  
990 Ft. from E. Line  
\_\_\_\_\_ Ft. from W. Line

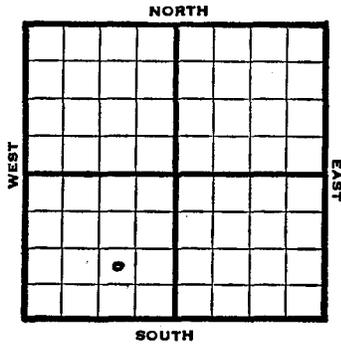

NW	SE	SW	REPORT
1947			Elev. 1307'
6/4			10" @ 240 Drlg 1210'
6/10			Mississippi 2715 Drlg. 2800'
6/17			Mississippi 2698 Correction Hunton 3088' Viola 3243-78' T.D. 5" @ 3278 RUST
6/24			"
7/1			TD 3287' 1000 Acid
7/8			TD 3296'
7-16			Drlg. 3395'
7/23			Viola 3243' Simpson 3447' T.D. 3452' Abandoned
			<b>ABANDONED</b>

Section 20 Township 14 Range 2W

Well No. 1 Cravens

Company L. D. Jackson Drlg .

