

KANSAS

Map No. 51 Sec. 28 Twp. 14 R. 2W.Well No. 1 HurstRyan Consolidated Company

Contractor

SECTION PLAT

0			
1			

_____ Ft. from N. Line

330 Ft. from S. Line

_____ Ft. from E. Line

330 Ft. from W. Line

FIRST REPORT

Location ✓

Rig up

Drilling and Remarks:

RECORD

Cased _____ in., _____ ft.

Sand _____

Gas _____

Oil _____

Total Depth _____

PRODUCTION

1st 24 hrs. Nat. _____

1st 24 hrs. after shot _____

Gas _____ Cu. Ft.

Dry Hole _____

Abandoned _____

Date

DEC 9 1936 19

S. J. LEWIS Scout

KANSAS

Map No. 57 Sec. 28 Twp. 14 R. 2W.Well No. 1 HurstRyan Consolidated Company

Contractor

SECTION PLAT

0			

_____ Ft. from N. Line

330 Ft. from S. Line

_____ Ft. from E. Line

330 Ft. from W. Line

ABANDONED

Location _____

Rig up

Drilling and Remarks:

SL 3405
HPW 3410

RECORD

Cased _____ in., _____ ft.

Sand _____

Gas _____

Oil _____

Total Depth 3415

PRODUCTION

1st 24 hrs. Nat. _____

1st 24 hrs. after shot _____

Gas _____ Cu. Ft.

Dry Hole ✓Abandoned ✓

Date

APR 7 1937 19

S. J. LEWIS Scout

KANSAS

Sabine

Map No. Sec. 28 Twp. 14 R. 2W

Well No. 1 Wuerth Farm

Ryan Consolidated Company

Ft. from N. Line

330

Ft. from S. Line

330


Ft. from E. Line

330

Ft. from W. Line

330

Elev. 1270

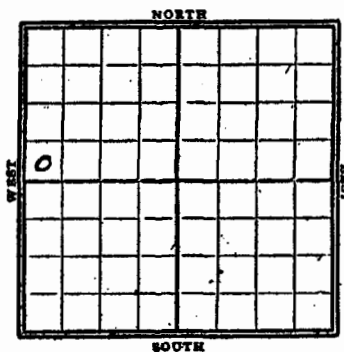

1937

4/7

Sil. 3405'.

T. D. 3415'.

Hole full water 3410'.

ABANDONED

Date	REPORT
1936	
12-9	Location
12/24	Rigging up
12/29	" "
1937	
1/7	Drlg. 1100'.
1/14	Shut down 1100'.
1/21	Drlg. 1400'.
1/28	Shut down 1400'.
2/4	" " "
2/11	Drlg. 1870'.
2/19	Shut Down 1870'
2/26	" " "
3/4	" " "
3/11	" " "
3/18	" " "
3/25	" " "
4/2	Drlg. 3125'
	OVER

Sabine
KANSAS

Section.....28.....Township.....14.....Range.....2-W

Well Number...1...Wuerth.....

Company.....Ryan Consolidated.....

