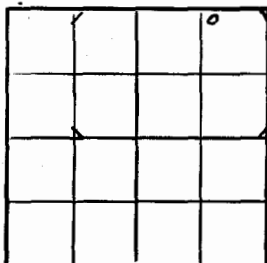


Pool Name SalinaMap No. 51 Sec. 30 Twp. 14 R. 2WWell No. #1 WhiteWestgate-Greenland CompanyFIRST REPORT Contractor

NW NE NE

SECTION PLAT

330 Ft. from N. Line Ft. from S. Line990 Ft. from E. Line Ft. from W. LineSalina

Location

Rig up

Drilling and Remarks:

8'-160 WOC

RECORD

Cased in. ft.Sand Gas Oil Total Depth

PRODUCTION


1st 24 hrs. Nat. 1st 24 hrs. after shot Gas Cu. Ft.Dry Hole Abandoned

Date

NOV 29 1944 19S. J. LEWIS ScoutPool Name SalinaMap No. KANSAS Sec. 30 Twp. 14 R. 2WWell No. 1 WhiteWestgate-Greenland CompanyCOMPLETED Contractor

NW NE NE

SECTION PLAT

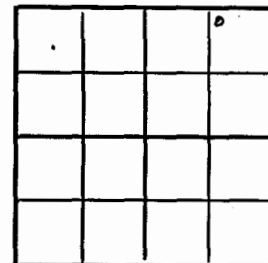330 Ft. from N. Line Ft. from S. Line990 Ft. from E. Line Ft. from W. LineSalina

Location

Rig up

Drilling and Remarks:

Vista 8407" @ 3210PO 3220100000000Pump 150000000Water82 1/2 ft

RECORD

Cased in. ft.Sand Gas Oil Total Depth 3220

PRODUCTION

1st 24 hrs. Nat. 1st 24 hrs. after shot Gas Cu. Ft.Dry Hole Abandoned

Date

JAN 17 1945 19S. J. LEWIS Scout

KANSAS

Saline

Sec. 30 Twp. 14 R. 2W

FORM 51 5M BRIX

KANSAS

Well No. #1 White Farm

Section 30 Township 14 Range 2W

Westgate-Greenland

Company


Saline

330 Ft. from N. Line

Ft. from S. Line

990 Ft. from E. Line

Ft. from W. Line

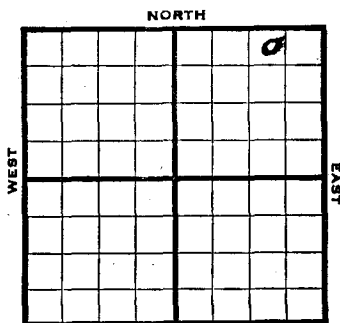

Saline NW NE NE

SOUTH

1944 Feb 12 REPORT

11/29 8' @ 160 WOC

12/6 Drlg. 1650

12/14 Viola 3210 drlg.

12/21 Lans 1990

Miss 2634

Hunton 3040

Riola 3210

TD 3220

7" @ 3210

RUST

12/29 TD 3267

700 oil & 1200 water

1945

1/3 TD 3286 - 1600 water

1000 oil PB 3220

1/10 1000 acid testing

1/17 Viola 3210

7" @ 3210

PB 3220

1000 acid

TD 3286

Pump 151 oil plus 35% wtr.

Grav. 37.4

COMPLETED

