

County Saline State Kansas
 Sec. 30 (Blk. 14 (Sur. 2W Map No.
 (Twp.) (Rge.)

Operator Mallard Drlg.

Well No. 1 Farm Quinn

Elev. Location SW SW NE

FIRST REPORT		330 Ft. From <u>S</u> Line <u>NE</u>	
		330 Ft. From <u>W</u> Line <u>Quarter</u>	
0		1st. Report <u>OCT 3 1951</u>	
		Completion	
		Remarks	
		Spudding Date <u>9-30-51</u>	

Drlg. Data Saline Pool

8" @ 142 drlg. 420

J. E. TYRA

County Saline State Kansas
 Sec. 30 (Blk. 14 (Sur. 2W Map No.
 (Twp.) (Rge.)

Operator Mallard Drlg.

Well No. 1 Farm Quinn

Elev. 1230 Location SW SW NE

ABANDONED		330 Ft. From <u>S</u> Line <u>NE</u>	
		330 Ft. From <u>W</u> Line <u>Quarter</u>	
0		1st. Report	
		Completion <u>OCT 24 1951</u>	
		Remarks <u>Saline Pool</u>	
		Spudding Date <u>9-30-51</u>	

Drlg. Data D & A TD 3252

8" @ 142 Viola 3220 DST 3220-25

open 1 hr. Rec. 40' hoem TD 3225

5" @ 3222 DD 3226 750 A FU water

DD 3252 D & A

J. E. TYRA

Saline

KANSAS

Sec. 30 Twp. 14 R. 2W

Well No. #1 Quinn Farm

Mallard Drlg. Company

Contractor


Ft. from N. Line

330 Ft. from S. Line

Ft. from E. Line

330 Ft. from W. Line

SW SW NE

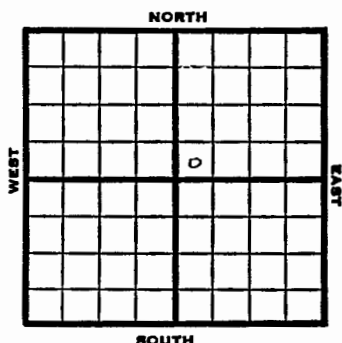

1951 Elev. 1230' REPORT

10/3 Spud 9-30-51
8" @ 142
Drlg. 420'

10/24 Spud 9-30-51
D&A TD 3252
8" @ 142
Viola 3220
DST 3220-25 open 1 hr.
Rec. 40' HOCM TD 3225
5" @ 3222 DD 3226 750 A
FU wtr. DD 3252
D&A

ABANDONED

Saline

KANSAS

Section 30 Township 14 Range 2 W

Well No. # 1 Quinn

Company Mallard Drlg.

