


Sec. 30 Twp. 14 R. 2W

Well No. #1 Balaum Farm
Phillips & Sanderson Company

E. K. Carey-Contr. Contractor
Saline Pool

990' Ft. from N. Line
Ft. from S. Line
330' Ft. from E. Line
Ft. from W. Line

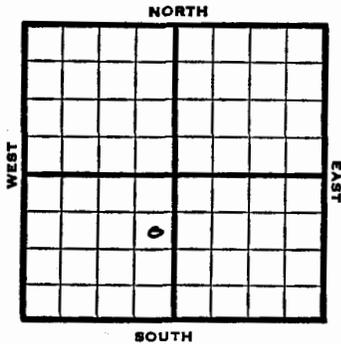


SE NE SW

Section 30 Township 14 Range 2-W

Well No. #1 Balaum

Company Phillips & Sanderson

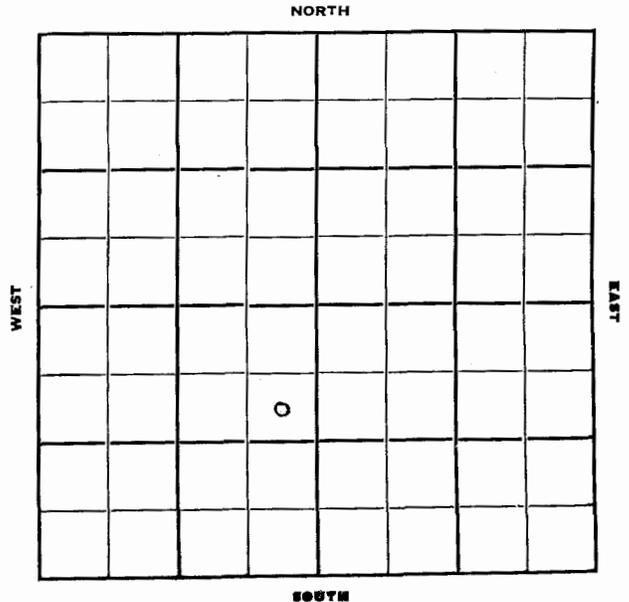

1950 Elev. 1233' REPORT

9/20 Spud 9-14-50
8-5/8" @ 200'
11/1 Drlg. 2000'
Spud 9-14-50
Oil Well TD 3225'
8-5/8" @ 200' Miss 2655'
Kinderhood 2932' Hunton 3044'
Mac. shl 3139' Dol. 3219-25
5 1/2" @ 3219' TD 3225'
FU 285' oil 250' wtr 16 hr.
1000 A S/234 BW 54 BOPD Comp.
COMPLETED