

Saline

KANSAS /
Map No. Sec. 31 Twp. 14 R. 2W


Well No. 1 Millikin

Margay Company

FIRST REPORT Contractor

NW SW SE

SECTION PLAT

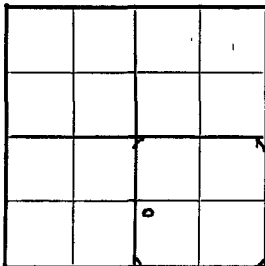

Ft. from N. Line

990 Ft. from S. Line

Ft. from E. Line

330 Ft. from W. Line

Wildcat

Location
Rig up
Drilling and Remarks:

Rotary

RECORD

Cased in, ft.

Sand

Gas

Oil

Total Depth

PRODUCTION

1st 24 hrs. Nat.

1st 24 hrs. after shot

Gas Cu. Ft.

Dry Hole

Abandoned

Date

MAR 8 1944 19 S. J. LEWIS Scout

Saline

KANSAS /
Map No. 51 Sec. 31 Twp. 14 R. 2W


Well No. 1 Millikin

Margay Company

ABANDONED Contractor

NW SW SE

SECTION PLAT

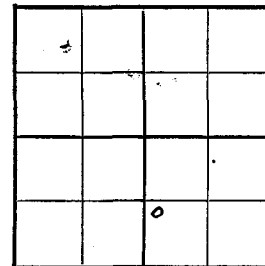

Ft. from N. Line

990 Ft. from S. Line

Ft. from E. Line

330 Ft. from W. Line

Wildcat

Location
Rig up
Drilling and Remarks:Hutton 8045
Nota 8230

RECORD

Cased in, ft.

Sand

Gas

Oil

Total Depth 3310

PRODUCTION

1st 24 hrs. Nat.

1st 24 hrs. after shot

Gas Cu. Ft.

Dry Hole

Abandoned

Date

APR 5 1944 19 S. J. LEWIS Scout

KANSAS

Saline

Sec. 31 Twp. 14 R. 2W

Well No. #1 Millikin Farm

Margay Company


Wildeat

Ft. from N. Line

990 Ft. from S. Line

Ft. from E. Line

330 Ft. from W. Line

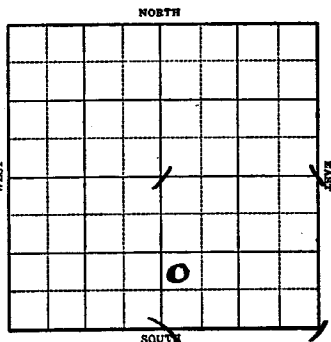

1944

REPORT

3/8 Rotary

3/18 "

3/22 8" @ 250 WOC.

3/29 Miss 2642
Drlg. 2691'

4/5 Hunton 3045
Viola 3230
TD 3310

ABANDONED

KANSAS

Saline

Section 31 Township 14 Range 2W

Well No. #1 Millikin

Company Margay

